

FILE DO NOT MAIL

SURVEY & REMONUMENTATION

LAND CORNER RECORDATION CERTIFICATE
Filing Requirement of Act 74, Mich. P.A. 1970

MAR 17 1998

For corners in

WAYNE (County)	Located in: Brownstown Township	Corner Code #
1. Public Land Survey	T <u>5S</u> R <u>10E</u>	<u>B-1</u>
	T _____ R _____	_____
	T _____ R _____	_____
	T _____ R _____	_____
2. Property Controlling in Section	S _____ T _____ R _____	_____
	S _____ T _____ R _____	_____
3. Miscellaneous Property in Sec.	S _____ T _____ R _____	_____
	S _____ T _____ R _____	_____


SECTION

Compliance with
ACT 345, P.A. 1990

APPROVED ON: 12-1-97 *[Signature]*
WAYNE COUNTY REMONUMENTATION
PEER GROUP COMMITTEE
Register of Deeds Stamp & File Number

4. Lot No. _____, Recorded Plat _____
5. Private Claims _____

I, Randy Kolehouse, in a field survey on November 21 19 97, do hereby certify that under requirements of P.A. 74 Michigan P.A. of 1970, the corner points mentioned in lines 1 and 2 above were in conformance with regulations and rules therefore as required in the current manual of survey instructions of the United States Department of the Interior, Bureau of Land Management or by a decree of a Court of Law and/or that the corner points mentioned in lines 3, 4 and 5 above were in conformance with the rules of the Michigan Board of Land Surveyors or by a Decree of a Court of Law; established, re-established, monumented, re-monumented, recovered, found as expressed below:

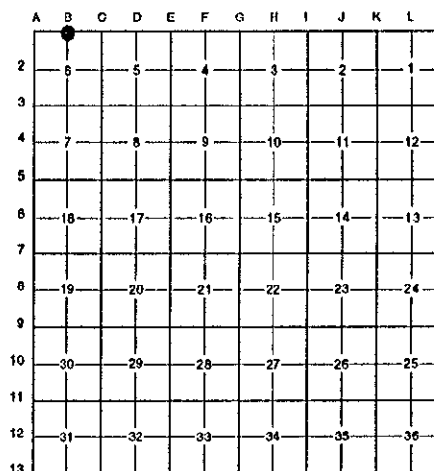

NOTE: Not more than 4 corners, all in the same town and range, may be recorded on this certificate.

A. Description of original monument and accessories and/or subsequent restoration:

B-1	This corner is common with B-13, T4S, R10E				
1817	G.L.O.	Fletcher	Notes		Post
1930's	WPA Notes	N/A	Section Map and Ties		N/A
1940	Plat	Miller	L.67 P.44		Conc. Monument
1940	Plat	Miller	L.67 P.45		Conc. Monument
1974	L.C.R.C.	Hooth #7966	L. 18906 P. 890		4" Conc. Monument

\$4.00 REMONUMENTATION

B. Description of corner evidence found and/or method applied in restoring or reestablishing corner:

B-1 The concrete monument and all but one witness has been destroyed by construction work in the area. Using several plat monuments in the above referenced plats, and the one remaining witness (nail w/MDSH tag, N. face power pole, S60°W, 76.22', R&M) from the L.C.R.C. referenced above, I calculated the position of the corner. The distance from the calculated position checks well East and West with WPA distances.

\$7.00 DEED

Measure West from Reset Corner to A-13, T4S, R10E, 2605.98' (WPA = 2607.08')
Measure East from Reset Corner to C-1 2563.56' (WPA = 2562.96')


RECORDED
FOREST E. YOUNGBLOOD, REGISTER OF DEEDS
WAYNE COUNTY, MI
Receipt #43169

C. Description of monument for corner and accessories established to perpetuate locating the position of the corner:

B-1 Set a 4" x 36" concrete monument with a 1/2" rebar and a 2" diameter aluminum cap stamped "Wayne Co. Remon. #25854" in a gravel drive 6" below the surface.

- "+" on SW Rim Sanitary MH N 81° E 94.14'
- Nail w/MDSH tag North face Power Pole S 60° W 76.22'
- Nail w/WCR tag in S Face Power Pole N 39° W 167.18'
- SE Corner Block Building N 03° E 158.58'

The selected location is accepted by the Contractor and is generally accepted by professional surveyors as the best available evidence of the position of the original corner.

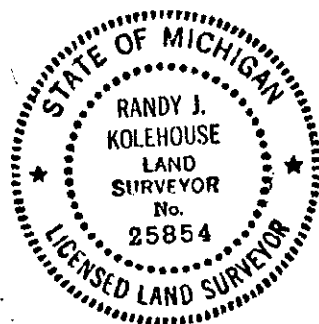

Signed by Randy J. Kolehouse Date 12/16/97
Surveyor's Michigan License No. 25854