

APR 05 1996

LAND CORNER RECORDATION CERTIFICATE  
Filing Requirement of Act 74, Mich. P.A. 1970

\$ 7.00 DEED  
\$ 4.00 REMONUMENTATION  
8 DEC 95 12:39 P.M. RECEIPT  
RECORDED

FOREST E. YOUNGBLOOD, REGISTERED SURVEYOR  
WAYNE COUNTY, MI

LIBER 28451 PAGE 504

Compliance with  
ACT 345, P.A. 1990

APPROVED ON: 11-28-95  
WAYNE COUNTY REMONUMENTATION  
PEER GROUP COMMITTEE

Register of Deeds Stamp & File Number

For corners in  
WAYNE COMMISSION  
(County)

Located in: Brownstown Corner Code #  
Township

- 1. Public Land Survey T 5S R 10E C-1  
T \_\_\_\_\_ R \_\_\_\_\_  
T \_\_\_\_\_ R \_\_\_\_\_  
T \_\_\_\_\_ R \_\_\_\_\_
- 2. Property Controlling S \_\_\_\_\_ T \_\_\_\_\_ R \_\_\_\_\_  
in Section S \_\_\_\_\_ T \_\_\_\_\_ R \_\_\_\_\_
- 3. Miscellaneous S \_\_\_\_\_ T \_\_\_\_\_ R \_\_\_\_\_  
Property in Sec. S \_\_\_\_\_ T \_\_\_\_\_ R \_\_\_\_\_

- 4. Lot No. \_\_\_\_\_, Recorded Plat \_\_\_\_\_
- 5. Private Claims \_\_\_\_\_

I, Randy Kolehouse, in a field survey on November 7 19 94, do hereby certify that under requirements of P.A. 74 Michigan P.A. of 1970, the corner points mentioned in lines 1 and 2 above were in conformance with regulations and rules therefore as required in the current manual of survey instructions of the United States Department of the interior, Bureau of Land Management or by a decree of a Court of Law and/or that the corner points mentioned in lines 3, 4 and 5 above were in conformance with the rules of the Michigan Board of Land Surveyors or by a Decree of a Court of Law; established, re-established, monumented, re-monumented, recovered, found as expressed below:

NOTE: Not more than 4 corners, all in the same town and range, may be recorded on this certificate.

A. Description of original monument and accessories and/or subsequent restoration:

C-1	1817	G.L.O. Notes	N/A	Post
	1930's	WPA Notes	N/A	Iron
	1973	WCRC Notes	N/A	Iron in Conc. Pavement Under 2" A.C. Cap

B. Description of corner evidence found and/or method applied in restoring or reestablishing corner:

- C-1 No point was found in road. Reset cor. from "Henry H. Sheeks Subdivision" L. 44 P. 42 and "Vanriper Subdivision" L. 44 P. 67. Points fall in C/L of Gibraltar Road (asphalt). Set P.K.


Measures East to C-13 T4S R10E = 110.37' (G.L.O. = 110.22') (WPA = 111.12') (110.20' WCRC)  
Measures East to D-1 T5S R10E = 2584.88' (G.L.O. = 2507.34') (WPA = 2588.72')

NOT A COMMON CORNER

C. Description of monument for corner and accessories established to perpetuate locating the position of the corner:


- C-1 Replaced P.K. with 1/2" rebar and aluminum cap stamped "Wayne Co. Remon." *IN NEW MONUMENT BOX*

SE Cor. Bldg. #25730 Gibraltar Road N 48° E 123.26'  
Nail w/Tag "WCR" NE Face 12" Maple S 37° E 54.49'  
Nail w/Tag "WCR" E Face 12" Maple S 10° W 40.67'  
Nail w/Tag "WCR" NE Face 12" Mt. Ash N 43° W 73.40'

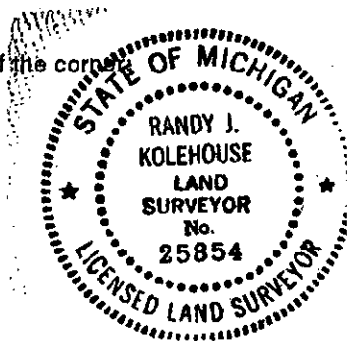

The selected location is accepted by the Contractor and is generally accepted by professional surveyors as the best available evidence of the position of the original corner.

Signed by Randy J. Kolehouse Date 12/2/95  
Surveyor's Michigan License No. 25854

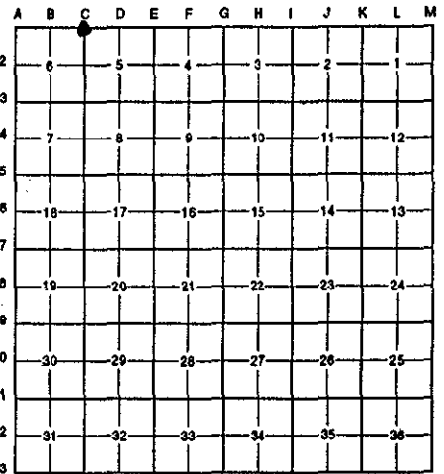

45262459

4e  
70  
D/2