

DEC 21 1998

SURVEY & REMONUMENTATION

FILE DO NOT MAIL

LAND CORNER RECORDATION CERTIFICATE  
Filing Requirement of Act 74, Mich. P.A. 1970

MAR 02 1999

For corners in

WAYNE (County) Located in: Brownstown Township Corner Code #


1. Public Land Survey	T 5S	R 10E	D-3
	T	R	
	T	R	
	T	R	
2. Property Controlling in Section	S	T	R
	S	T	R
3. Miscellaneous Property in Sec.	S	T	R
	S	T	R

4. Lot No. \_\_\_\_\_, Recorded Plat \_\_\_\_\_  
5. Private Claims \_\_\_\_\_

SECTION

Compliance with ACT 345, P.A. 1990  
APPROVED ON: 12-15-98  
WAYNE COUNTY REMONUMENTATION PEER GROUP COMMITTEE  
Register of Deeds Stamp & File Number

I, Bruce Antcliff, in a field survey on October 29 19 98, do hereby certify that under requirements of P.A. 74 Michigan P.A. of 1970, the corner points mentioned in lines 1 and 2 above were in conformance with regulations and rules therefore as required in the current manual of survey instructions of the United States Department of the interior, Bureau of Land Management or by a decree of a Court of Law and/or that the corner points mentioned in lines 3, 4 and 5 above were in conformance with the rules of the Michigan Board of Land Surveyors or by a Decree of a Court of Law; established, re-established, monumented, re-monumented, recovered, found as expressed below:

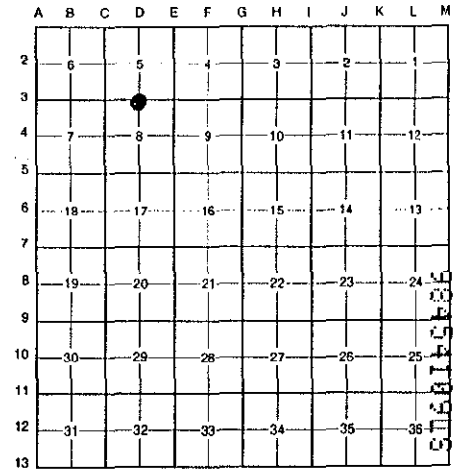

NOTE: Not more than 4 corners, all in the same town and range, may be recorded on this certificate.

A. Description of original monument and accessories and/or subsequent restoration:

D-3				Notes	Post
1.	1817	G.L.O.	Fletcher		
2.	1930's	WPA Notes	N/A	Section Map and Ties	N/A
3.	1955	Supervisor's Brownstown #3	Tobin	L. 77 P. 64	N/A
4.	1994	L.C.R.C.	Kapelczac #24598	L. 27896 P. 708	Set Iron w/Cap #24598

B. Description of corner evidence found and/or method applied in restoring or reestablishing corner:

D-3 Found a 1/2" rebar with cap #24598 4' North of a fence line running East per the following witnesses from LCRC L.27896, P.708:

- Fnd. PK w/washer W side 48" Sycamore, N5W, 18.62' (R=18.63')
- Fnd. PK w/washer W side 8" Elm, S25E, 24.67' (R=24.68')
- Fnd. PK w/washer NW side 10" Ash, S35W, 27.79' (R=27.81')
- Fnd. PK w/washer N side 36" Sycamore, West, 9.37' (R=9.37')

\$7.00 DEED  
RECORDED  
FOREST E. YOUNGLOOD, REGISTER OF DEEDS  
WAYNE COUNTY, MI  
Receipt #101302  
\$4.00 REMONUMENTATION

Also checks with several found corners within Supervisor's Brownstown Plat No. 3.


Measure East to E-3 = 2575.60' (WPA = 2575.13')(Super. Brownstown No. 3 = 2575.13')(G.L.O. = 2640.00')

C. Description of monument for corner and accessories established to perpetuate locating the position of the corner:

D-3 Replaced rebar and cap with a 4" x 36" concrete monument with a 2" diameter aluminum cap stamped "Wayne Co. Remon. #25826." (In wooded area.)

- Set Nail w/W.C.R. Tag W Side 48" Sycamore N 05° W 18.64'
- Set Nail w/W.C.R. Tag W Side 8" Elm S 25° E 24.66'
- Set Nail w/W.C.R. Tag NW Side 10" Ash S 35° W 27.76'
- Set Nail w/W.C.R. Tag N Side 36" Sycamore West 9.37'

The selected location is accepted by the Contractor and is generally accepted by professional surveyors as the best available evidence of the position of the original corner.

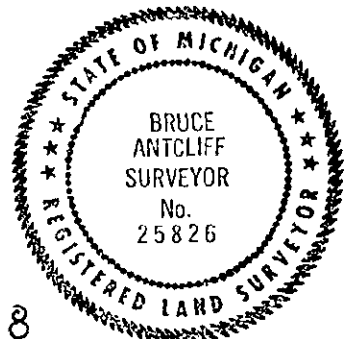

Signed by Bruce Antcliff Date 12-17-98

Surveyor's Michigan License No. 25826

R LCR 7 4R 1PG U DPJ

Liber-30031

Page-703.5

12/21/1998 09:25AM