

SURVEY & REMONUMENTATION

RATIFIED
PA
MONROE
date: 10-9-94
County Rep: [Signature]

APR 28 1995

RECEIVED FOR RECORD
94 DEC -9 PM 12:50

COMMISSION LAND CORNER RECORDATION CERTIFICATE Filing Requirement of Act 74, Mich. P.A. 1970

For corners in

<u>MONROE</u> <small>(County)</small>	Located In: <u>BERLIN</u> <u>TWP.</u>	Corner Code <u>##</u> <u>D-7</u>
1. Public Land Survey	T <u>5</u> S R <u>10</u> E	<u>D-7</u>
	T _____ R _____	_____
	T _____ R _____	_____
	T _____ R _____	_____
2. Property Controlling in Section	S _____ T _____ R _____	_____
	S _____ T _____ R _____	_____
3. Miscellaneous Property in Sec.	S _____ T _____ R _____	_____
	S _____ T _____ R _____	_____
4. Lot No. _____, Recorded Plat _____		

Leri Allen
REGISTER OF DEEDS
MONROE COUNTY, MICH.

Register of Deeds Stamp & File Number

5. Private Claims
1994 MONROE COUNTY REMONUMENTATION PROGRAM
Peer Group approved corner on 10/4/1994 per Act 345 of 1990.

1. G.B. WARNKE, JR., in a field survey on 11/14/1994, 19____, do hereby certify that under requirements of P.A. 74, Michigan P.A. of 1970, the corner points mentioned in lines 1 and 2 above were in conformance with regulations and rules therefore as required in the current manual of survey instructions of the United States Department of the Interior, Bureau of Land Management or by a decree of a Court of Law and/or that the corner points mentioned in lines 3, 4 and 5 above were in conformance with the rules of the Michigan Board of Land Surveyors or by a Decree of a Court of Law, established, re-established, monumented, re-monumented, recovered, found as expressed below:

	A	B	C	D	E	F	G	H	I	J	K	L	M
2	6	5	4	3	2	1							
3													
4	7	8	9	10	11	12							
5													
6	18	17	16	15	14	13							
7													
8	19	20	21	22	23	24							
9													
10	30	29	28	27	26	25							
11													
12	31	32	33	34	35	36							
13													

NOTE: Not more than 4 corners, all in the same town and range, may be recorded on this certificate.

A. Description of original monument and accessories and/or subsequent restoration:
D-7, T5S, R10E, Berlin Township, Monroe County - ID No. 58


1/4 Corner Common to Sections 17 and 20 (Ready Road - 1/2 mile East of Armstrong Road - tarby)
1817, G.L.O. Surveyor, Joseph Fletcher, set 1/4 section post at the average distance and witnessed: W. Ash 9 inch N.82° E. 15 links & W. Ash 10 inch S.49° E. 13 links. 1863, witness 10 inch Hick. S.73° W. 44.38 feet. Road Commission plans for Ready Road, sheet 6 of 6, notes corner stone 11.8 feet south of sta. 287 + 74.0. Detroit Edison witnesses show stone 3.5 feet south of south edge of black top. 1951, M.D.O.T. notes high point of stone along south side of road. 1976, Glenn Richard found stone, set iron & cap bent to be over point of stone per survey recorded in Liber 727, Page 419. 1977, A.J. Marino notes F.I. Pipe over stone. 1991, G.B. Warnke found capped (#13040) iron over stone.

B. Description of corner evidence found and/or method applied in restoring or reestablishing corner:

D-7 - Found capped (#13040) iron over stone. 11/14/1994, set 1 inch x 36 inch iron pipe with brass remonumentation cap to replace iron over stone.

C. Description of monument for corner and accessories established to perpetuate locating the position of the corner:

D-7 - Set 1 inch x 36 inch iron pipe with brass remonumentation cap to replace iron over stone and is accepted as the best available evidence of the position of the original corner and Witnesses:
North 5° East 41.10 feet to found double headed nail and tag southeast side utility pole
North 15° East 12.20 feet to found P.K. nail in road
North 11 feet +/- to centerline of pavement
North 60° East 29.89 feet to a found railroad spike in road
North 65° East 73.85 feet to set 1/4 inch square chisle shaft over found 3/4 inch iron pipe (12 inches deep) Monroe County Road Commission angle point
North 2.5 feet +/- to South edge of pavement
North 50° West 103.12 feet to top nut of hydrant.

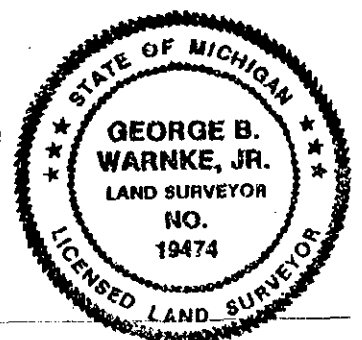

-Signed by [Signature] Date 11/14/1994
-Surveyor's Michigan License No. 19474