

**SURVEY & REMONUMENTATION**

APR 05 1996

**LAND CORNER RECORDATION CERTIFICATE**  
 Filing Requirement of Act 74, Mich. P.A. 1970

For corners in **COMMISSION**

WAYNE Located in: Brownstown Corner Code #  
 (County) Township

- |                                    |             |              |            |
|------------------------------------|-------------|--------------|------------|
| 1. Public Land Survey              | T <u>5S</u> | R <u>10E</u> | <u>E-1</u> |
|                                    | T _____     | R _____      | _____      |
|                                    | T _____     | R _____      | _____      |
|                                    | T _____     | R _____      | _____      |
| 2. Property Controlling in Section | S _____     | T _____      | R _____    |
|                                    | S _____     | T _____      | R _____    |
| 3. Miscellaneous Property in Sec.  | S _____     | T _____      | R _____    |
|                                    | S _____     | T _____      | R _____    |

4. Lot No. \_\_\_\_\_, Recorded Plat \_\_\_\_\_  
 5. Private Claims \_\_\_\_\_

**LIBER 28451 PAGE 505**


Compliance with  
 ACT 345, P.A. 1990  
 APPROVED ON: 11-28-95  
**WAYNE COUNTY REMONUMENTATION**  
**PEER GROUP COMMITTEE**  
 Register of Deeds Stamp & File Number

I, Randy Kolehouse, in a field survey on October 21 19 94, do hereby certify that under requirements of P.A. 74 Michigan P.A. of 1970, the corner points mentioned in lines 1 and 2 above were in conformance with regulations and rules therefore as required in the current manual of survey instructions of the United States Department of the interior, Bureau of Land Management or by a decree of a Court of Law and/or that the corner points mentioned in lines 3, 4 and 5 above were in conformance with the rules of the Michigan Board of Land Surveyors or by a Decree of a Court of Law; established, re-established, monumented, re-monumented, recovered, found as expressed below:

**NOTE: Not more than 4 corners, all in the same town and range, may be recorded on this certificate.**

**A. Description of original monument and accessories and/or subsequent restoration:**

E-1	1817	G.L.O. Notes	N/A	Set Post
	1930's	WPA Notes	N/A	N/A
	1980	L.C.R.C. L. 20887 P. 564 & 565	Cantrell	Set P.K.

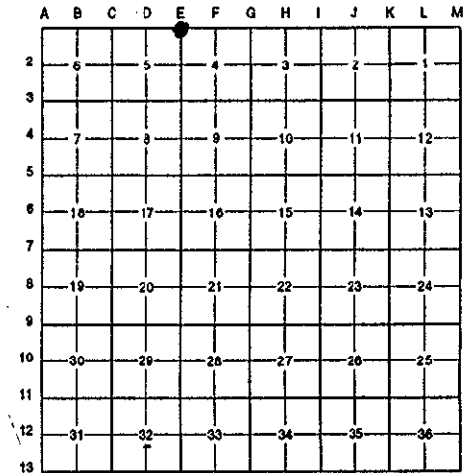

\$ 4.00 REMONUMENTATION  
 \$ 7.00 DEED  
 8 DEC 95 12:40 P.M. RECEIPT  
 RECORDED  
 FOREST E. YOUNGBLOOD, REGISTER  
 WAYNE COUNTY, MI  
**45262460**  
 EDG

**B. Description of corner evidence found and/or method applied in restoring or reestablishing corner:**

E-1 I found a P.K. w/Shiner in C/L of Gibraltar Road (asphalt) running E-W which agrees with the following witnesses.

L.C.R.C. L. 20887 P. 564  
 P.K. W. Face D.E. Pole North 33.96'  
 P.K. NW Face M.B.T. Pole SW 68.98'


Measures East to F-1 = 2649.92' (G.L.O. = 2640') (WPA = 2651.07')  
 Measures East to E-13 T4S R10E = 250.62' (WPA = 251.95')  
 Measures West to D-1 = 2611.74' (G.L.O. = 2640') (WPA = 2610.62')  
 Measures West to D-13 T4S R10E = 2401.84' (WPA = 2400.67')

*NOT A COMMON CORNER*

**C. Description of monument for corner and accessories established to perpetuate locating the position of the corner:**

E-1 I replaced the found P.K. with 1/2" rebar with aluminum cap stamped "Wayne Co. Remon." *IN A NEW MONUMENT BOX*

P.K. w/Shiner E Face Util. Pole Due North 33.75'  
 Nail w/Tag "WCRC Ref. Pnt." S Face Util. Pole N 79° E 117.49'  
 Nail w/Tag "WCRC Ref. Pnt." N Face Util. Pole S 67° E 100.00'  
 Nail w/Shiner E Face Util. Pole S 70° W 69.05'

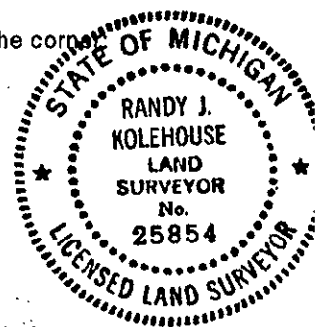

The selected location is accepted by the Contractor and is generally accepted by professional surveyors as the best available evidence of the position of the original corner.

Signed by Randy J. Kolehouse Date 12/2/95  
 Surveyor's Michigan License No. 25854