

DEC 21 1998

FILE DO NOT MAIL

LAND CORNER RECORDATION CERTIFICATE
Filing Requirement of Act 74, Mich. P.A. 1970

SURVEY & REMONUMENTATION

MAR 02 1999

For corners in

Form with fields for WAYNE (County), Located in: City of Flat Rock, Corner Code #, and numbered sections 1-5 for Public Land Survey, Property Controlling, Miscellaneous, and Private Claims.

SECTION

Compliance with ACT 345, P.A. 1990

APPROVED ON: 12-15-98 [Signature]
WAYNE COUNTY REMONUMENTATION PEER GROUP COMMITTEE
Register of Deeds Stamp & File Number

I, Bruce Antcliff, in a field survey on October 29, 1998, do hereby certify that under requirements of P.A. 74 Michigan P.A. of 1970, the corner points mentioned in lines 1 and 2 above were in conformance with regulations and rules therefore as required in the current manual of survey instructions of the United States Department of the interior, Bureau of Land Management or by a decree of a Court of Law and/or that the corner points mentioned in lines 3, 4 and 5 above were in conformance with the rules of the Michigan Board of Land Surveyors or by a Decree of a Court of Law; established, re-established, monumented, re-monumented, recovered, found as expressed below:

NOTE: Not more than 4 corners, all in the same town and range, may be recorded on this certificate.

A. Description of original monument and accessories and/or subsequent restoration:

Table with 6 columns: E-2, 1, 1817, G.L.O., Fletcher, Notes, Post. Rows describe 1817 G.L.O., 1930's WPA Notes, and 1956 Huron Drive Estates No. 4.

B. Description of corner evidence found and/or method applied in restoring or reestablishing corner:

E-2 No corner was found at this location. I proportioned the WPA distances and angles to this corner to reestablish the position. It checks well N/S with WPA and checks within approx. one foot to the northeast corner of Huron Drive Estates No. 4.

\$4.00 REMONUMENTATION RECORDED
FOREST E. YOUNGBLOOD, REGISTER OF DEEDS
WAYNE COUNTY, MI
Receipt #101302

Measure North to E-1 = 2453.22' (WPA = 2453.03')(G.L.O. = 2633.4')
Measure South to E-3 = 2619.68' (WPA = 2619.48')(G.L.O. = 2640.00')

\$7.00 DEED


C. Description of monument for corner and accessories established to perpetuate locating the position of the corner:

E-2 Set a 4" x 36" concrete monument with a 1/2" rebar and a 2" diameter aluminum cap stamped "Wayne Co. Remon. #25826." (In wooded area.)

- Fnd. P.K. S Side 12" Ash N 52° E 12.42'
Fnd. Nail w/GW Tag #54917" E Side 20" Poplar S 20° W 20.45'
Fnd. PK. N Side 21" Elm N 39° W 35.94'
Set Nail w/W.C.R. Tag SE Face 20" Poplar N 28° E 32.25'

The selected location is accepted by the Contractor and is generally accepted by professional surveyors as the best available evidence of the position of the original corner.

Signed by Bruce Antcliff Date 12-17-98
Surveyor's Michigan License No. 25826

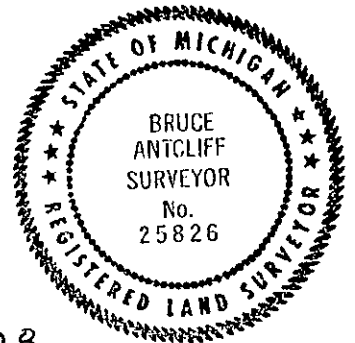

R LCR 7 4R 1 PG U [Signature]

Libert-30031

Page-784.8

12/21/1998 09:26AM