

APR 25 1995

RC 1614

COMMISSION

LAND CORNER RECORDATION CERTIFICATE  
Filing Requirement of Act 74, Mich. P.A. 1970

For corners in

<u>WAYNE</u> (County)	Located in: Brownstown Township	Corner Code #
1. Public Land Survey	T <u>5S</u> R <u>10E</u>	<u>E-3</u>
	T _____ R _____	_____
	T _____ R _____	_____
	T _____ R _____	_____
2. Property Controlling in Section	S _____ T _____ R _____	_____
	S _____ T _____ R _____	_____
3. Miscellaneous Property in Sec.	S _____ T _____ R _____	_____
	S _____ T _____ R _____	_____

L127800PA681

Compliance with ACT 345, P.A. 1990  
APPROVED ON: 12-7-94 *[Signature]*  
WAYNE COUNTY REMONUMENTATION  
PEER GROUP COMMITTEE

Register of Deeds Stamp & File Number


4. Lot No. \_\_\_\_\_, Recorded Plat \_\_\_\_\_  
5. Private Claims \_\_\_\_\_

I, Randy Kolehouse, in a field survey on October 21 19 94, do hereby certify that under requirements of P.A. 74 Michigan P.A. of 1970, the corner points mentioned in lines 1 and 2 above were in conformance with regulations and rules therefore as required in the current manual of survey instructions of the United States Department of the Interior, Bureau of Land Management or by a decree of a Court of Law and/or that the corner points mentioned in lines 3, 4 and 5 above were in conformance with the rules of the Michigan Board of Land Surveyors or by a Decree of a Court of Law; established, re-established, monumented, re-monumented, recovered, found as expressed below:

NOTE: Not more than 4 corners, all in the same town and range, may be recorded on this certificate.

A. Description of original monument and accessories and/or subsequent restoration:

E-3	1817	G.L.O. Notes	N/A	Post
	1930's	WPA Notes	N/A	N/A
	1954	Plat L. 77 P. 63	N/A	N/A

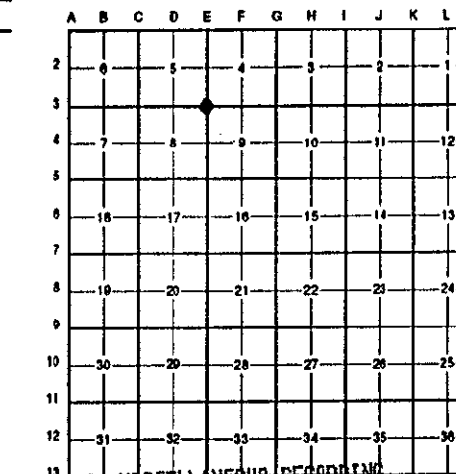

B. Description of corner evidence found and/or method applied in restoring or reestablishing corner:

E-3 Found 2" dia. iron pipe at the intersection of a fence running North, South and West. No witnesses have been recorded for this corner. This corner agrees with Supervisor's Brownstone Plat No. 2 L. 77 P. 63 and WPA distances.

Measures 10' both West and South to reference monuments as shown on Supervisor's Brownstone Plat No. 2  
Measures East to F-3 = 2658.62' (G.L.O. = 2641.98') (WPA = 2658.62' S-4 - 2658.92' S-9)

C. Description of monument for corner and accessories established to perpetuate locating the position of the corner:

E-3 I replaced the 2" dia. pipe with a 4" x 30" concrete monument with aluminum cap stamped "Wayne Co. Remon."

- Nail w/Tag "WCR" E Face 30" Poplar N 10° E 29.82'
- P.K. S Face 30" Maple S 87° E 42.08'
- Conc. Mon. S 10° W 10.00'
- Nail w/Tag "GW #45679" E Face 24" Poplar S 37° W 43.05'
- Conc. Mon. N 89° W 10.00'
- Nail w/Tag "WCR" N Face 12" Maple N 56° W 33.85'

The selected location is accepted by the Contractor and is generally accepted by professional surveyors as the best available evidence of the position of the original corner.

Signed by Randy J. Kolehouse Date 12/14/94  
Surveyor's Michigan License No. 25854

