

SURVEY & REMONUMENTATION

DEC 21 1998

MAR 02 1999

LAND CORNER RECORDATION CERTIFICATE
Filing Requirement of Act 74, Mich. P.A. 1970

SECTION

For corners in

<u>WAYNE</u> (County)	Located in: Brownstown Township	Corner Code #
1. Public Land Survey	T <u>5S</u> R <u>10E</u>	<u>E-4</u>
	T _____ R _____	_____
	T _____ R _____	_____
	T _____ R _____	_____
2. Property Controlling in Section	S _____ T _____ R _____	_____
	S _____ T _____ R _____	_____
3. Miscellaneous Property in Sec.	S _____ T _____ R _____	_____
	S _____ T _____ R _____	_____
4. Lot No. _____, Recorded Plat _____		
5. Private Claims _____		

Compliance with
ACT 345, P.A. 1990

APPROVED ON: 12-15-98
WAYNE COUNTY REMONUMENTATION
PEER GROUP COMMITTEE


Register of Deeds Stamp & File Number

I, Bruce Antcliff, in a field survey on September 23 19 98, do hereby certify that under requirements of P.A. 74 Michigan P.A. of 1970, the corner points mentioned in lines 1 and 2 above were in conformance with regulations and rules therefore as required in the current manual of survey instructions of the United States Department of the Interior, Bureau of Land Management or by a decree of a Court of Law and/or that the corner points mentioned in lines 3, 4 and 5 above were in conformance with the rules of the Michigan Board of Land Surveyors or by a Decree of a Court of Law; established, re-established, monumented, re-monumented, recovered, found as expressed below:

NOTE: Not more than 4 corners, all in the same town and range, may be recorded on this certificate.

A. Description of original monument and accessories and/or subsequent restoration:

E-4	1.	1817	G.L.O.	Fletcher	Notes	Post
	2.	1930's	WPA Notes	N/A	Section Map and Ties	N/A
	3.	1997	L.C.R.C.	Kohn #26459	L. 29736 P. 1442-1443	1" Pipe
	4.	1997	Huron Meadows Sub.	Kohn #26459	N/A	N/A

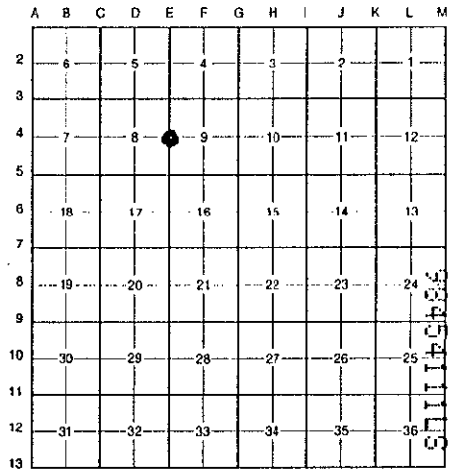

\$4.00 REMONUMENTATION

B. Description of corner evidence found and/or method applied in restoring or reestablishing corner:

E-4 Found a 3/4" pipe in woods which checked the following witnesses from LCRC L.29736, P.1442:

- Fnd. P.K. w/Tag "GW #16390" E Face 30" Poplar N 06° W 38.92' (R=38.95')
 - Fnd. P.K. w/Tag "GW #16393" N Face 12" Twin Maple S 68° E 35.72' (R=35.69')
 - Fnd. P.K. w/Tag "GW #16392" E Face 18" Maple S 30° W 34.45' (R=34.47')
 - Fnd. P.K. w/Tag "GW #16391" N Face 18" Ash N 83° W 23.64' (R=23.64')
- Also checks with several corners in Huron Meadows Sub.

\$7.00 DEED
RECORDED
FOREST E. YOUNGBLOOD, REGISTER OF DEEDS
WAYNE COUNTY, MI
Receipt #101302

Measure North to E-3 = 2615.37'(WPA = 2619.75')(G.L.O. = 2640.00')(Huron Meadows Sub. = 2615.40')
(LCRC L.29736, P.1442 = 2615.40')

C. Description of monument for corner and accessories established to perpetuate locating the position of the corner:

E-4 Replaced 3/4" pipe with a 4" x 36" concrete monument with a 1/2" rebar and a 2" diameter aluminum cap stamped "Wayne Co. Remon. #25826." (In wooded area.)


- Fnd. P.K. w/Tag "GW #16390" E Face 30" Poplar N 06° W 38.92'
- Fnd. P.K. w/Tag "GW #16393" N Face 12" Twin Maple S 68° E 35.72'
- Fnd. P.K. w/Tag "GW #16392" E Face 18" Maple S 30° W 34.45'
- Fnd. P.K. w/Tag "GW #16391" N Face 18" Ash N 83° W 23.64'

The selected location is accepted by the Contractor and is generally accepted by professional surveyors as the best available evidence of the position of the original corner.

Signed by Bruce Antcliff Date 12-17-98

Surveyor's Michigan License No. 25826

R LCR 7 4R 1P6 U. DBL

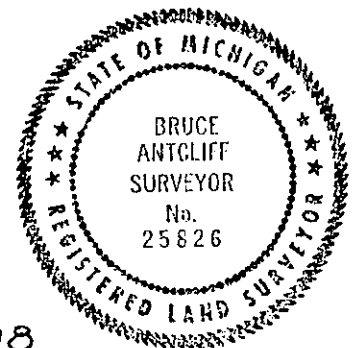

Libert-30031

Page-765.0

12/21/1998

09:26AM