

APR 05 1996

LAND CORNER RECORDATION CERTIFICATE
Filing Requirement of Act 74, Mich. P.A. 1970

For corners in

COMMISSION

| Wayne Co. (County) | Located in: City of Flat Rock | Corner Code # |
|---------------------------------------|----------------------------------|---------------|
| 1. Public Land Survey | T <u>5 S</u> R <u>10 E</u> | <u>F-1</u> |
| | T _____ R _____ | _____ |
| | T _____ R _____ | _____ |
| | T _____ R _____ | _____ |
| 2. Property Controlling in Section | S _____ T _____ R _____ | _____ |
| | S _____ T _____ R _____ | _____ |
| 3. Miscellaneous Property in Sec. | S _____ T _____ R _____ | _____ |
| | S _____ T _____ R _____ | _____ |
| 4. Lot No. _____, Recorded Plat _____ | | |
| 5. Private Claims _____ | | |


LIBER 28451 PAGE 506

Compliance with
ACT 345, P.A. 1990

APPROVED ON: 11-28-95 *DRJ*
WAYNE COUNTY REMONUMENTATION
PEER GROUP COMMITTEE

Register of Deeds Stamp & File Number

I, Randy Kolehouse, in a field survey on Aug. 24, 1995, do hereby certify that under requirements of P.A. 74 Michigan P.A. of 1970, the corner points mentioned in lines 1 and 2 above were in conformance with regulations and rules therefore as required in the current manual of survey instructions of the United States Department of the interior, Bureau of Land Management or by a decree of a Court of Law and/or that the corner points mentioned in lines 3, 4 and 5 above were in conformance with the rules of the Michigan Board of Land Surveyors or by a Decree of a Court of Law; established, re-established, monumented, re-monumented, recovered, found as expressed below:

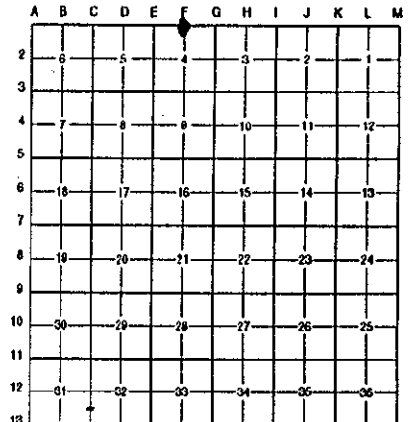

NOTE: Not more than 4 corners, all in the same town and range, may be recorded on this certificate.

A. Description of original monument and accessories and/or subsequent restoration:

F-1 This corner was not originally set by the G.L.O.

| Year | WPA | unknown | Section map | Iron |
|--------|---------|---------------|---------------|----------------------------|
| 1930's | WPA | unknown | Section map | Iron |
| 1972 | D.E.Co. | | Field notes | 3/8" Rod |
| 1973 | WCRC | Coon | Section ties | Iron in conc. pav't |
| 1973 | LCRC | Brabant 17611 | L.18556 P.769 | 1/2" Iron |
| 1984 | LCRC | Pitts 10702 | L.22079 P.372 | 3/4" Iron pipe in Mon. box |
| 1986 | LCRC | Sandomierski | L.23013 P.679 | Bent 3/4" iron in Mon. box |
| 1989 | D.E.Co. | Vaderna 25878 | Unrecorded | 1/2" Rerod in handhole |

\$ 4.00 REMONUMENTATION

\$ 7.00 DEED

8 DEC 95 12:40 P.M.

RECEIVED
RECORDED
FOREST E. YOUNGLOOD, REGISTER
WAYNE COUNTY, MI
45262461

EDS

Note: This corner is not common with F-13 T4S R10E.

B. Description of corner evidence found and/or method applied in restoring or reestablishing corner:

F-1 I found a 1/2" rebar in a 4" concrete monument in a monument box. At the centerline of Olmstead Rd. (asphalt) and 4' south of the centerline of Gibraltar Rd. (conc.). Which agrees with the following:

| W.C.R.C. Witness | L.C.R.C. L18556,P769 |
|-----------------------------------|----------------------------------|
| Top nut fire hydrant SE'ly 81.45' | Spike & cap in p. pole SW 83.33' |
| D.E. pole SW'ly 83.33' | |
| Iron S-33 T4S,R10E East 245.62' | |

| L.C.R.C. L22079,P372 | L.C.R.C. L23013,P679 |
|--|--|
| 83.29' SW to a nail w/WCRC brass tag in the NW side of D.E. Co. pole | S20°E 82.04' to the tip of arrow on fire hydrant |
| | S23°W 83.20' to WCRC tag NW side DE pole |


Measures west to E-1 T5S,R10E = 2649.92' (WPA = 2651.07')
Measures east to G-1 T5S,R10E = 2649.06' (WPA = 2649.77')
Measures east to F-13 T4S,R10E = 245.75' (WPA = 245.62'), (D.E.Co. = 245.77')

C. Description of monument for corner and accessories established to perpetuate locating the position of the corner:

F-1 I set a 2" aluminum cap "Wayne County Remonumentation #25854" on existing monument in an existing box. From which:

| | |
|-----------------------------------|--------------|
| Chiseled "+" SW corner light base | N39°E 50.96' |
| Top nut fire hydrant | S16°E 82.06' |
| PK nail SE face p.pole | S27°E 82.89' |
| PK nail E face p.pole | N23°W 63.03' |

The selected location of a corner, although not established by an original government survey, is accepted as the best available evidence of the position of the corner.

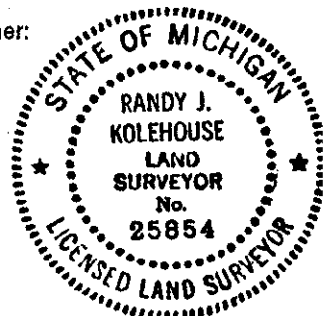

Signed by Randy J. Kolehouse

Date 12/2/95

Surveyor's Michigan License No. 25854

4R
70
D