

APR 05 1996

COMMISSION

LAND CORNER RECORDATION CERTIFICATE
Filing Requirement of Act 74, Mich. P.A. 1970

For corners in

WAYNE

(County)

Located in: Brownstown Corner Code #
Township

- 1. Public Land Survey T 5S R 10E G-1
2. Property Controlling in Section S T R
3. Miscellaneous Property in Sec. S T R

LIBER 28451 PAGE 508

Compliance with ACT 345, P.A. 1990

APPROVED ON: 11-28-95
WAYNE COUNTY REMONUMENTATION PEER GROUP COMMITTEE

Register of Deeds Stamp & File Number

- 4. Lot No. Recorded Plat
5. Private Claims

I, Randy Kolehouse, in a field survey on November 7, 1994, do hereby certify that under requirements of P.A. 74 Michigan P.A. of 1970, the corner points mentioned in lines 1 and 2 above were in conformance with regulations and rules therefore as required in the current manual of survey instructions of the United States Department of the interior, Bureau of Land Management or by a decree of a Court of Law and/or that the corner points mentioned in lines 3, 4 and 5 above were in conformance with the rules of the Michigan Board of Land Surveyors or by a Decree of a Court of Law; established, re-established, monumented, re-monumented, recovered, found as expressed below:

Grid table with columns A-M and rows 2-13. A dot is marked at the intersection of column G and row 2.

NOTE: Not more than 4 corners, all in the same town and range, may be recorded on this certificate.

A. Description of original monument and accessories and/or subsequent restoration:

Table with columns: G-1, 1817, G.L.O. Notes, WPA Notes, L.C.R.C. L. 23013 P. 681, Cert. Survey Unrecorded, N/A, N/A, Sandomierski, Vaderna

Post \$ 4.00 REMONUMENTATION
N/A \$ 7.00 DEED
4" in Box DEC 95 12:40 P.M. RECEIP
Rerod in Box RECORDED
FOREST E. YOUNGBLOOD, REGISTER
WAYNE COUNTY, MI

45262463

B. Description of corner evidence found and/or method applied in restoring or reestablishing corner:

G-1 I found chisled "+" in Gibraltar Road (concrete) running E-W which agrees with the following:


L.C.R.C. L. 23013 P. 681
P.K. Nail SW Side Tele. Pole S 44° E 45.56'
Tip of Arrow on Hydrant N 14° W 64.80'

NOT A COMMON CORNER

Measured West to F-1 = 2649.07' (G.L.O. = 2640') (WPA = 2649.77') (D.E. Co. 2306.08')
Measured South to G-2 = 2470.37' (G.L.O. = 2613.60') (WPA = 2488.45' S-4 - 2491.20' S-3 - 2504.04' S-3?)
Measured East to G-13 T4S R10E = 247.36' (G.L.O. = 250.80') (WPA = 245.36')

C. Description of monument for corner and accessories established to perpetuate locating the position of the corner:

G-1 Replaced found "+" with a 1/2 rebar with aluminum cap stamped "Wayne Co. Remon." IN NEW MONUMENT BOX
Tip of Arrow on Hydrant N 14° W 64.69'
Nail w/Tag "WCR Witness" NW Face 12" Box Elder N 41° E 86.17'
P.K. SW Face Util. Pole S 39° E 45.62'
NE Cor. Outer Rim. CB S 78° W 52.43'

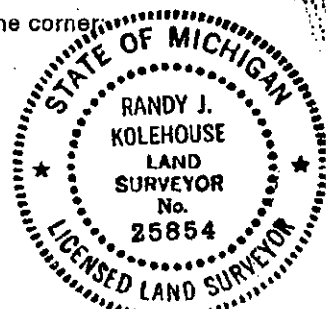

The selected location is accepted by the Contractor and is generally accepted by professional surveyors as the best available evidence of the position of the original corner.