

SURVEY & REMONUMENTATION

DEC 02 1993

RC 1090

COMMISSION

LAND CORNER RECORDATION CERTIFICATE
Filing Requirement of Act 74, Mich. P.A. 1970

LI 26951 PA 711

For corners in

Wayne <small>(County)</small>	Located In:	Corner Code #
1. Public Land Survey	T <u>5S</u> R <u>10E</u>	<u>G-2</u>
	T _____ R _____	_____
	T _____ R _____	_____
	T _____ R _____	_____
2. Property Controlling in Section	S _____ T _____ R _____	_____
	S _____ T _____ R _____	_____
3. Miscellaneous Property in Sec.	S _____ T _____ R _____	_____
	S _____ T _____ R _____	_____

Compliance with
ACT 345, P.A. 1990
APPROVED ON: 10-28-93 P.J.
WAYNE COUNTY REMONUMENTATION
PEER GROUP COMMITTEE
Register of Deeds Stamp & File Number

RC 1090

4. Lot No. _____, Recorded Plat _____
5. Private Claims _____

	A	B	C	D	E	F	G	H	I	J	K	L	M
2	6	5	4	3	2	1							
3													
4	7	8	9	10	11	12							
5													
6	18	17	16	15	14	13							
7													
8	19	20	21	22	23	24							
9													
10	30	29	28	27	26	25							
11													
12	31	32	33	34	35	36							
13													

I, Bruce Antcliff, in a field survey on August 27, 19 93, do hereby certify that under requirements of P.A. 74, Michigan P.A. of 1970, the corner points mentioned in lines 1 and 2 above were in conformance with regulations and rules therefore as required in the current manual of survey instructions of the United States Department of the Interior, Bureau of Land Management or by a decree of a Court of Law and/or that the corner points mentioned in lines 3, 4 and 5 above were in conformance with the rules of the Michigan Board of Land Surveyors or by a Decree of a Court of Law; established, re-established, monumented, re-monumented, recovered, found as expressed below:

NOTE: Not more than 4 corners, all in the same town and range, may be recorded on this certificate.

A. Description of original monument and accessories and/or subsequent restoration:

- GLO-Post
- LCRC (1973) - 1" Iron Pipe (L 18598, P 145)
- LCRC (1986) - 1-1/2" Iron Pipe (L 23013, P 680)

B. Description of corner evidence found and/or method applied in restoring or reestablishing corner:


Found 1-3/8" Iron Pipe - Measured to SE S.4 - Distances checked well with WPA Surveys

C. Description of monument for corner and accessories established to perpetuate locating the position of the corner:

Set 4" x 36" Conc. Mon. with Wayne County Remonumentation Marker and Cap #25826.

- Witnesses
- P.K. East side 10" Thronapple, SW, 35.27'
 - P.K. West side 6" Oak, SSW, 9.36'
 - Nail & Tag S'y side 6" Oak, SE, 17.00'
 - P.K. NW side 12" Oak, NE, 25.92'

The selected location is accepted by the Contractor and is generally accepted by professional surveyors as the best available evidence of the position of the original corner.

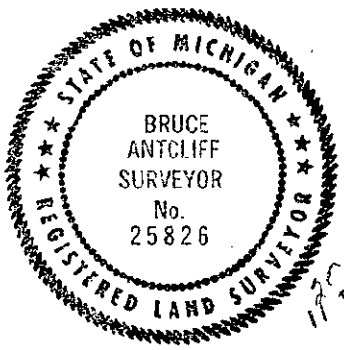

Signed by Bruce Antcliff Date 11-10-93
Surveyor's Michigan License No. 25826