

SURVEY & REMONUMENTATION

APR 25 1995

COMMISSION

RC 1616

\$ 13.00 MISCELLANEOUS RECORDING
 28 DEC 94 9:43 A.M. RECEIPT# 160
 RECORDED
 FOREST E. YOUNGBLOOD, REGISTERED OF DEEDS
 WAYNE COUNTY, MI

LAND CORNER RECORDATION CERTIFICATE
 Filing Requirement of Act 74, Mich. P.A. 1970

For corners in

<u>WAYNE</u> (County)	Located in: <u>Brownstown</u> Township	Corner Code # <u>H-3</u>
1. Public Land Survey	T <u>5S</u> R <u>10E</u>	<u>H-3</u>
	T _____ R _____	_____
	T _____ R _____	_____
	T _____ R _____	_____
2. Property Controlling in Section	S _____ T _____ R _____	_____
	S _____ T _____ R _____	_____
3. Miscellaneous Property In Sec.	S _____ T _____ R _____	_____
	S _____ T _____ R _____	_____
4. Lot No. _____, Recorded Plat _____		
5. Private Claims _____		

L127800PA683

Compliance with
 ACT 345, P.A. 1990


APPROVED ON: 12-7-94 *DRJ*
 WAYNE COUNTY REMONUMENTATION
 PEER GROUP COMMITTEE

Register of Deeds Stamp & File Number

RC 1616

I, Randy Kolehouse, In a field survey on October 13 19 94, do hereby certify that under requirements of P.A. 74 Michigan P.A. of 1970, the corner points mentioned in lines 1 and 2 above were in conformance with regulations and rules therefore as required in the current manual of survey instructions of the United States Department of the Interior, Bureau of Land Management or by a decree of a Court of Law and/or that the corner points mentioned in lines 3, 4 and 5 above were in conformance with the rules of the Michigan Board of Land Surveyors or by a Decree of a Court of Law; established, re-established, monumented, re-monumented, recovered, found as expressed below:

NOTE: Not more than 4 corners, all in the same town and range, may be recorded on this certificate.

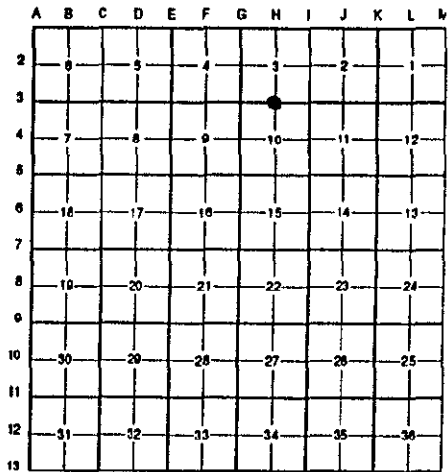

A. Description of original monument and accessories and/or subsequent restoration:

H-3	1817	G.L.O. Notes	N/A	Post
	1930's	WPA Notes	N/A	Ironin Lead Pipe
	?	L.C.R.C. L. 21836 P. 195	Wilkerson	Conc. Mon.
	1973	WCRC Notes	N/A	Mon. 1" Below Gravel

B. Description of corner evidence found and/or method applied in restoring or reestablishing corner:

H-3 I found a 3/4" pipe inside a 4" dia. concrete monument in the C/L of Woodriff Road (gravel) running E-W. Checks good with WPA dist. West to G-3. Also checks WCRC witnesses.

WCRC Notes

Nail w/Tag In D.E. Pole SE'ly 83.12' (83.06' m)
 Nail w/Tag 20" Oak North 103.11' (102.87' m)

Measures East to I-3 = 2601.61' (G.L.O. = 2635.05') (WPA = 2601.46' Sec. 3 - 2601.70' Sec. 10)
 Measures West to C/L Fort Street = 516.45' (WPA = 516.40' Sec. 3 - 516.53' Sec. 10)
 Measures West to G-3 = 2625.12' (G.L.O. = 2635.05') (WPA = 2635.05' Sec. 3 - 2627.69' Sec. 10)


C. Description of monument for corner and accessories established to perpetuate locating the position of the corner:

H-3 Set aluminum cap stamped "Wayne Co. Remon." on existing concrete monument.

- Nail w/Tag "WCR" E Face 42" Oak N 06° E 102.87'
- Nail w/Tag "WCRC" N Face Ul. Pole S 64° E 83.06'
- "+" SE Cor. Bridge S 86° W 120.49'
- "+" NE Cor. Bridge N 74° W 120.58'

The selected location is accepted by the Contractor and is generally accepted by professional surveyors as the best evidence of the position of the original corner.

Signed by Randy J. Kolehouse Date 12/14/94
 Surveyor's Michigan License No. 25854

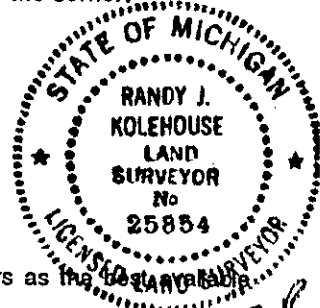

2 R
110
MISC