

APR 05 1996

COMMISSION

LAND CORNER RECORDATION CERTIFICATE
Filing Requirement of Act 74, Mich. P.A. 1970

For corners in


Wayne Co. (County)	Located in: City of Rockwood	Corner Code #
1. Public Land Survey	T <u>5 S</u> R <u>10 E</u>	<u>1-4</u>
	T _____ R _____	_____
	T _____ R _____	_____
	T _____ R _____	_____
2. Property Controlling in Section	S _____ T _____ R _____	_____
	S _____ T _____ R _____	_____
3. Miscellaneous Property in Sec.	S _____ T _____ R _____	_____
	S _____ T _____ R _____	_____

LIBER 28451 PAGE 509
Compliance with ACT 345, P.A. 1990

APPROVED ON: 11-28-95
WAYNE COUNTY REMONUMENTATION
PEER GROUP COMMITTEE

Register of Deeds Stamp & File Number

- 4. Lot No. _____, Recorded Plat _____
- 5. Private Claims _____

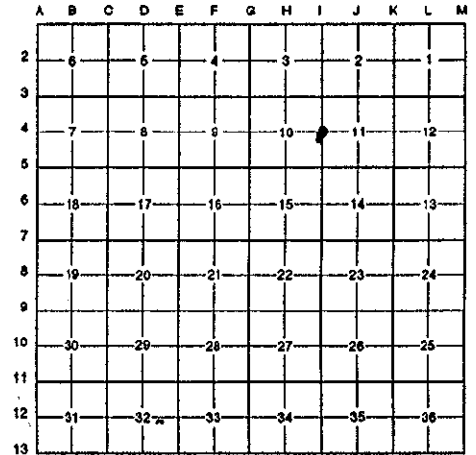

I, Randy Kolehouse, in a field survey on Nov. 3 1995, do hereby certify that under requirements of P.A. 74 Michigan P.A. of 1970, the corner points mentioned in lines 1 and 2 above were in conformance with regulations and rules therefore as required in the current manual of survey instructions of the United States Department of the Interior, Bureau of Land Management or by a decree of a Court of Law and/or that the corner points mentioned in lines 3, 4 and 5 above were in conformance with the rules of the Michigan Board of Land Surveyors or by a Decree of a Court of Law; established, re-established, monumented, re-monumented, recovered, found as expressed below:

NOTE: Not more than 4 corners, all in the same town and range, may be recorded on this certificate.

A. Description of original monument and accessories and/or subsequent restoration:

I-4	1885	GLO	Goodell	Notes	Post
	1930's	WPA	2" solid bar	Section map	Unknown
	1974	Cert. Survey	Arthurs #11358	L.18994,P.905	I.P. stake
	1992	L.C.R.C.	Dunn #30081	L.25638,P.709	Iron pipe

\$ 4.00 REMONUMENTATION
\$ 7.00 DEED
8 DEC 95 12:40 P.M. RECEIP
RECORDED
FOREST E. YOUNGBLOOD, REGISTER EDS
WAYNE COUNTY, MI

95262464

B. Description of corner evidence found and/or method applied in restoring or reestablishing corner:

I-4 1/2" ID pipe; found remains of old fence material N, S, E & W. Also found old stump which appears to be within 1' ± of WPA witness. Measured to NW Section 11 - distance is short of WPA Survey by 10' ±. Liparoto Estates No. 1 shows distance from W 1/4 Section 11 to SW Section 11. Distance is long of WPA Survey by 10' ±. Tied irons to west of corner - they appear to agree with the location as monumented. Since old fencing, existing survey irons and plat of Liparoto Estates support the current location, I also accepted it, believing the WPA surveys to be in error.

- L.C.R.C. L25638,P709
- PK Nail in SE face of 15" Deciduous N40°E 44.13'
- PK Nail in N face of 6" Maple S80°E 15.92'
- PK Nail in E face of 36" Oak S5°W 48.89'
- PK Nail in NE face of 12" Oak N10°W 18.80'

Measures south to I-5 T5S,R10E = 2606.95' (GLO = 2640'),(WPA =2596.09'sec.10,2595.79'sec.11)(Dunn=2606.69')
Measures north to I-3 T5S,R10E = 2611.05' (GLO = 2640'),(WPA =2619.84'sec.10,2621.27'sec.11)


C. Description of monument for corner and accessories established to perpetuate locating the position of the corner:

I-4 I replaced 1/2" pipe with a 2" aluminum cap stamped "Wayne County Remonumentation #25854" on a 4"x36" concrete monument.

- PK Nail in SE face of 18" Elm N40°E 44.10'
- PK Nail in N face of 8" Maple S78°E 15.90'
- PK Nail in E face of 36" Oak S6°W 48.88'
- PK Nail in NE face of 15" Oak N10°W 18.87'

NOT IN ROADWAY

The selected location is accepted by the Contractor and is generally accepted by professional surveyors as the best available evidence of the position of the original corner.

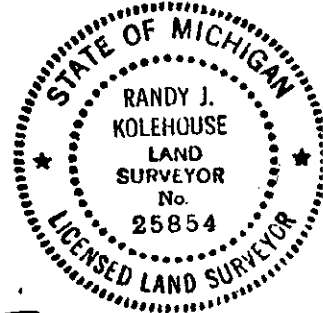

Signed by Randy J. Kolehouse
Surveyor's Michigan License No. 25854

Date 12/2/95

4k
7L