

DEC 02 1993

RC 1093

COMMISSION

LAND CORNER RECORDATION CERTIFICATE
Filing Requirement of Act 74, Mich. P.A. 1970

LI 26951 PA 714

For corners in

Wayne (County)	Located In:	Corner Code #
1. Public Land Survey	T 5S R 10E	1-5
	T R	
	T R	
	T R	
2. Property Controlling in Section	S T R	
	S T R	
3. Miscellaneous Property in Sec.	S T R	
	S T R	

Compliance with
ACT 345, P.A. 1990

APPROVED ON: 10-28-93
WAYNE COUNTY REMONUMENTATION
PEER GROUP COMMITTEE

Register of Deeds Stamp & File Number

- 4. Lot No. _____, Recorded Plat _____
- 5. Private Claims _____

	A	B	C	D	E	F	G	H	I	J	K	L	RC 1093
2	6	5	4	3	2	1							
3													
4	7	8	9	10	11	12							
5													
6	18	17	16	15	14	13							
7													
8	19	20	21	22	23	24							
9													
10	30	29	28	27	26	25							
11													
12	31	32	33	34	35	36							
13													

I, Bruce Antcliff, in a field survey on August 24, 19 93, do hereby certify that under requirements of P.A. 74, Michigan P.A. of 1970, the corner points mentioned in lines 1 and 2 above were in conformance with regulations and rules therefore as required in the current manual of survey instructions of the United States Department of the Interior, Bureau of Land Management or by a decree of a Court of Law and/or that the corner points mentioned in lines 3, 4 and 5 above were in conformance with the rules of the Michigan Board of Land Surveyors or by a Decree of a Court of Law; established, re-established, monumented, re-monumented, recovered, found as expressed below:

NOTE: Not more than 4 corners, all in the same town and range, may be recorded on this certificate.

A. Description of original monument and accessories and/or subsequent restoration:

- GLO-Post
- WPA (1930's) - Iron
- LCRC (1992) - 3/8" Rebar in Mon. Box (L 25624, P 538)
- LCRC (1992) - I.P. in Mon. Box (L 25638, P 709)

B. Description of corner evidence found and/or method applied in restoring or reestablishing corner:


1/2" Rebar/Conc. Mon. in Mon. Box; Measured to S1/4 S.11 - Distances checked well with WPA Surveys.

C. Description of monument for corner and accessories established to perpetuate locating the position of the corner:

Set Wayne County Remonumentation Marker and Cap #25826 on Existing Monument

- Witnesses
- P.K. Nail W. Face P.P./L.P., NE, 70.70'
 - NW Cor. House #20001, SSE, 115.60'
 - Top Cen. Fire Hyd., SSW, 30.61'
 - P.K. Nail S. side P.P./L.P., WNW, 153.09'

The selected location is accepted by the Contractor and is generally accepted by professional surveyors as the best available evidence of the position of the original corner.

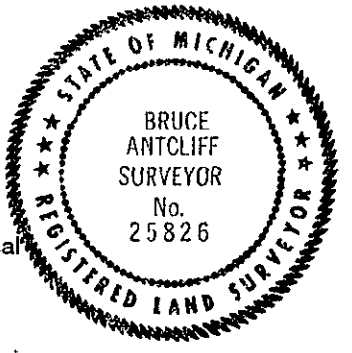

 REGISTERED LAND SURVEYORS
 MICHIGAN

Signed by Bruce Antcliff Date 11-10-93
 Surveyor's Michigan License No. 25826

Handwritten initials