

FILE DO NOT MAIL

LAND CORNER RECORDATION CERTIFICATE
Filing Requirement of Act 74, Mich. P.A. 1970

For corners in

Wayne (County) Located In: City of Rockwood Corner Code #


Liber-30864 Page-26
99595877 12/30/1999
F.E. Youngblood, Wayne Co. Register of Deeds
RDANDSYL

Table with 3 columns: Survey Type, Township/Range/East, and Corner Code #. Includes rows for Public Land Survey, Property Controlling in Section, and Miscellaneous Property in Sec.

Compliance with ACT 345, P.A. 1990
APPROVED ON: 12-8-99
WAYNE COUNTY REMONUMENTATION PEER GROUP COMMITTEE
Register of Deeds Stamp & File Number

4. Lot No. , Recorded Plat
5. Private Claims

I, Michael S. Hoben, in a field survey on Dec. 2, 1999 do hereby state that under requirements of P.A. 74, Michigan P.A. of 1970, the corner points mentioned in lines 1 and 2 above were in conformance with regulations and rules therefore as required in the current manual of survey instructions of the United States Department of the Interior, Bureau of Land Management or by a decree of a Court of Law and /or that the corner points mentioned in lines 3, 4 and 5 above were in conformance with the rules of the Michigan Board of Land Surveyors or by a Decree of a Court of Law; established, re-established, monumented, recovered, found as expressed below:

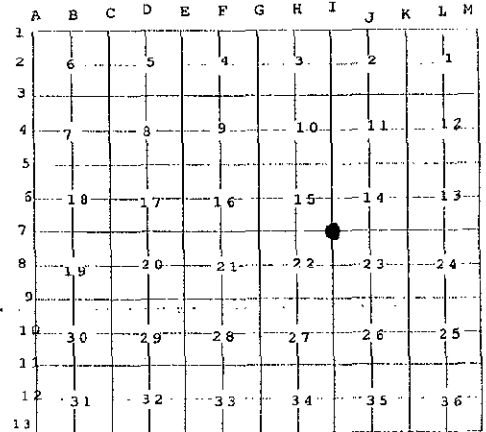

NOTE: Not more than 2 corners, all in the same town and range, may be recorded on this certificate.

A. Description of original monument and accessories and/or subsequent restoration:

Table with 4 columns: Corner Code #, Description, Name, and Date. Lists monuments for corner I-7 including WPA, LCRC, and various surveyors' monuments.

B. Description of corner evidence found and/or method applied in restoring or reestablishing corner:

I-7 I didn't find any evidence of this corner in the field. Using the LCRC by G. Warnke, I calculated the location of this point, which still falls in an active gravel quarry.

Distance to I-5 = 5250.14' (GLO = 5280')(WPA = 5250.14')(LCRC = 5250.14')
Distance to H-7 = 2664.29' (WPA & LCRC = 2664.29')
Distance to I-8 = 2573.07' (GLO = 2640')(WPA = 2572.82')

N 1° E 5250.14' Found WCRemon mon. in box for I-5
N 1° E 2683.23' Found iron for I-6 "Earth Tech #35994"
N 87° E 5266.95' Found WCRemon mon. in box for K-7
S 2° E 2573.07' Found MCRemon mon. in box for I-8
S 87° W 2664.29' Found pinch pipe for H-7

RE... & ...
FEB 28 2000
SECTION



WPA witnesses 1930
SE 25.72' to P.K. nail in 12" willow tree (gone)
SW 109.14' to P.K. nail in 12" Thorn Apple Tree (gone)
LCRC 1991
No monument set -- active landfill
LCRC 1999
No point set. In an active gravel quarry.

C. Description of monument for corner and accessories established to perpetuate locating the position of the corner:
I-7 No point set. In an active gravel quarry.

Signed by Michael S. Hoben Date Dec 27, 1999
Surveyor's Michigan License No. 35994

FORM APPROVED BY MICHIGAN STATE BOARD OF LAND SURVEYORS, JAN. 28, 1971

REVISED MAY 14, 1975
REVISED JAN., 1983
REVISED OCT., 1999

R LCR 9 4R 1Pg A DPZ