

SURVEY & REMONUMENTATION

MAY 20 1997

COMMISSION

RECEIVED

96 DEC 13 PM 3:13

LAND CORNER RECORDATION CERTIFICATE  
Filing Requirement of Act 74, Mich. P.A., 1970

*[Signature]*  
REGISTER OF DEEDS  
MONROE COUNTY, MICHIGAN

For corners in

<u>Monroe</u> (County)	Located In:	Corner Code #
	<u>Berlin Twp.</u>	
1. Public Land Survey	<u>T 5S R 10E</u>	<u>L-8</u>
	<u>T R</u>	
	<u>T R</u>	
	<u>T R</u>	
2. Property Controlling in Section	<u>S T R</u>	
	<u>S T R</u>	
3. Miscellaneous Property in Sec.	<u>S T R</u>	
	<u>S T R</u>	

Register of Deeds Stamp & File Number

4. Lot No. \_\_\_\_\_, Recorded Plat \_\_\_\_\_

5. Private Claims \_\_\_\_\_

I, Bruce Antcliff, in a field survey on February, 19 96 do hereby state that under requirements of P.A. 74, Michigan P.A. of 1970, the corner points mentioned in lines 1 and 2 above were in conformance with regulations and rules therefore as required in the current manual of survey instructions of the United States Department of the Interior, Bureau of Land Management or by decree of a Court of Law and / or that the corner points mentioned in lines 3, 4 and 5 above were in conformance with the rules of the Michigan Board of Land Surveyors or by a Decree of a Court of Law; established, re-established, monumented, recovered, found as expressed below:

NOTE: Not more than 2 corners, all in the same town and range, may be recorded on this certificate.

Monroe County Road Commission Corner

A. Description of original monument and accessories and/or subsequent restoration:

Quarter corner common to Sections 22 & 23, T5S, R10E / Wassanova Road, Asphalt over stone. GLO Surveyor set wood post, Black Oak, 10", N38W, 15 links; White Ash, 12", S63E, 24 links

7/15/74 Arthur C. Crossman found 3/4" iron pipe, LCRC Liber 1, Page 426  
PK Nail in east side 24" tree, S30W, 68.18'; Nail/cap NE side tel. pole, N85W, 13.82';  
PK Nail in east side of 18" tree, N30W, 74.71'

12/15/76 Boyd W. Arthurs found stone; PK Nail in east side 24" tree, SW, 68.29';  
Nail/cap NE side of utility pole, West, 14.02'; PK Nail in east side of 18" Hickory, NW, 74.83'

B. Description of corner evidence found and/or method applied in restoring or re-establishing corner:


Found large granite stone and 3/4" iron pipe 0.2' west of stone. Iron pipe was driven beside stone leaning east over stone. 8/95, MCRC removed stone and excavated. Found pieces of old red brick under stone. Did not find any evidence of government post.

C. Description of monument for corner and accessories established to perpetuate locating the position of the corner:

Set 1" x 36" iron pipe with brass remonumentation cap inside monument box to replace stone and is accepted as the best evidence of the position of the original corner.

Witnesses:  
N50W, 44.48', set 5/8" rebar for witness  
West, 139.08', Nail/shiner in North face of 26" Oak  
S35W, 76.31', set 5/8" rebar for witness  
S60E, 33.14', Chiseled "+" in North face of fire hydrant

RATIFIED BY PEER GROUP  
PA 345 OF 1990  
MONROE COUNTY, MICHIGAN  
date: 8/27/1996  
County Rep.: \_\_\_\_\_

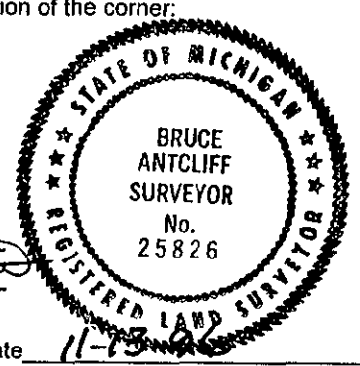

Signed by Bruce Antcliff

Date 11-13-96

Surveyor's Michigan License No. 25826