

SURVEY & REMONUMENTATION

DEC 02 1993

RC 1094

LAND CORNER RECORDATION CERTIFICATE
 Filing Requirement of Act 74, Mich. P.A. 1970

LI 26951 PA 715


COMMISSION

For corners in

Wayne (County)	Located In:	Corner Code #
1. Public Land Survey	T <u>5S</u> R <u>10E</u>	<u>J-3</u>
	T _____ R _____	_____
	T _____ R _____	_____
	T _____ R _____	_____
2. Property Controlling in Section	S _____ T _____ R _____	_____
	S _____ T _____ R _____	_____
3. Miscellaneous Property in Sec.	S _____ T _____ R _____	_____
	S _____ T _____ R _____	_____
4. Lot No. _____, Recorded Plat _____		
5. Private Claims _____		

Compliance with
 ACT 345, P.A. 1990
 APPROVED ON: 10-28-93
 WAYNE COUNTY REMONUMENTATION
 PEER GROUP COMMITTEE
 Register of Deeds Stamp & File Number

I, Bruce Antcliff, in a field survey on August 21, 19 93, do hereby certify that under requirements of P.A. 74, Michigan P.A. of 1970, the corner points mentioned in lines 1 and 2 above were in conformance with regulations and rules therefore as required in the current manual of survey instructions of the United States Department of the Interior, Bureau of Land Management or by a decree of a Court of Law and/or that the corner points mentioned in lines 3, 4 and 5 above were in conformance with the rules of the Michigan Board of Land Surveyors or by a Decree of a Court of Law; established, re-established, monumented, re-monumented, recovered, found as expressed below:

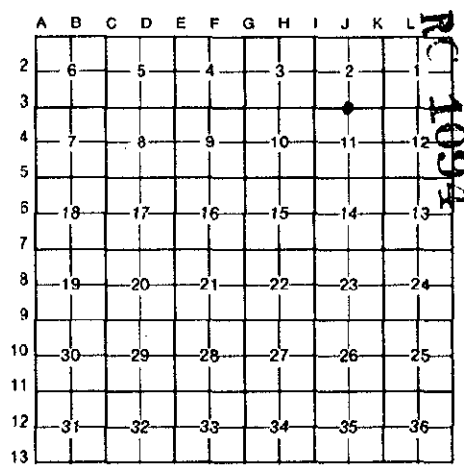

NOTE: Not more than 4 corners, all in the same town and range, may be recorded on this certificate.

A. Description of original monument and accessories and/or subsequent restoration:

- GLO-Post
- WPA (1930's) - Iron
- Edison Notes (1960) - 5/8" Rebar
- LCRC (1976) - 1/2" Iron Rod
- LCRC (1976) - 1/2" Iron Rod

B. Description of corner evidence found and/or method applied in restoring or reestablishing corner:

1/2" Rod (deteriorated) inside 3/4" OD Pipe; measured to NW S.11 - checks well with WPA Survey and Edison measurement.


C. Description of monument for corner and accessories established to perpetuate locating the position of the corner:

Set 4" x 36" Conc. Mon. with Wayne County Remonumentation Marker and Cap #25826

Witnesses

- "+" S'y edge Rim San. MH, NE, 33.75'
- "+" N'y edge Rim San. MH, SE, 26.32'
- WCRC Nail & Tag E'y side Guy Pole, SSE, 52.51'
- WCRC Nail & Tag W'y side P.P., NNW, 52.33'

The selected location is accepted by the Contractor and is generally accepted by professional surveyors as the best available evidence of the position of the original corner.

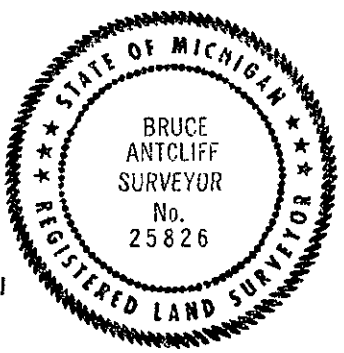

Signed by Bruce Antcliff Date 11-10-93
 Surveyor's Michigan License No. 25826

