

SURVEY & REMONUMENTATION

DEC 02 1993

COMMISSION

RC 1095

LAND CORNER RECORDATION CERTIFICATE
Filing Requirement of Act 74, Mich. P.A. 1970

For corners in

<u>Wayne</u> <small>(County)</small>	Located In:	Corner Code #
1. Public Land Survey	T <u>5S</u> R <u>10E</u>	<u>J-5</u>
	T _____ R _____	_____
	T _____ R _____	_____
	T _____ R _____	_____
2. Property Controlling in Section	S _____ T _____ R _____	_____
	S _____ T _____ R _____	_____
3. Miscellaneous Property in Sec.	S _____ T _____ R _____	_____
	S _____ T _____ R _____	_____
4. Lot No. _____, Recorded Plat _____		
5. Private Claims _____		

LI 26951 PA 716

Compliance with
ACT 345, P.A. 1990

APPROVED ON: 10-28-93 *PA*
WAYNE COUNTY REMONUMENTATION
PEER GROUP COMMITTEE

Register of Deeds Stamp & File Number

RC 1095

A	B	C	D	E	F	G	H	I	J	K	L
2	6	5	4	3	2	1					
3											
4	7	8	9	10	11	12					
5											
6	18	17	16	15	14	13					
7											
8	19	20	21	22	23	24					
9											
10	30	29	28	27	26	25					
11											
12	31	32	33	34	35	36					
13											

I, Bruce Antcliff, in a field survey on August 24, 19 93, do hereby certify that under requirements of P.A. 74, Michigan P.A. of 1970, the corner points mentioned in lines 1 and 2 above were in conformance with regulations and rules therefore as required in the current manual of survey instructions of the United States Department of the Interior, Bureau of Land Management or by a decree of a Court of Law and/or that the corner points mentioned in lines 3, 4 and 5 above were in conformance with the rules of the Michigan Board of Land Surveyors or by a Decree of a Court of Law; established, re-established, monumented, re-monumented, recovered, found as expressed below:

NOTE: Not more than 4 corners, all in the same town and range, may be recorded on this certificate.

A. Description of original monument and accessories and/or subsequent restoration:

GLO-Post
 WPA (1930's) - Iron
 LCRC (1983) - Conc. Mon. in Box (L 21659, P 209)

B. Description of corner evidence found and/or method applied in restoring or reestablishing corner:

1/2" Rebar/Conc. Mon. in Mon. Box; measured to SW S.11 & SE S.11 - Measurements check well with WPA Surveys.

C. Description of monument for corner and accessories established to perpetuate locating the position of the corner:

Set Wayne County Remonumentation Marker and Cap #25826 on existing monument.


Witnesses

- P.K. Nail S. Side P.P., NE, 67.40'
- P.K. Nail Top of End Guardrail Post, ENE, 74.14'
- P.K. Nail Top of End Guardrail Post, ESE, 84.18'
- ☉ R.R. Spike N. Side 15" Oak, WSW, 60.92'

The selected location is accepted by the Contractor and is generally accepted by professional surveyors as the best available evidence of the position of the original corner.

Signed by Bruce Antcliff
 Surveyor's Michigan License No. 25826

Date 11-10-93

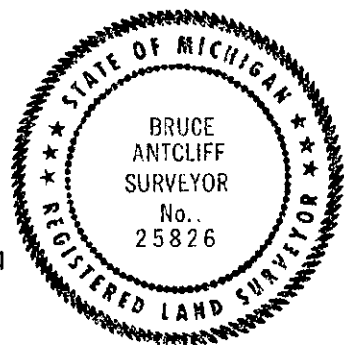

*2K
11m*