

**SURVEY &  
REMONUMENTATION**

NOV 10 1997

COMMISSION

RATIFIED BY PEER GROUP  
PA 345 OF 1990  
MONROE COUNTY, MICHIGAN

date: 7/22/1997

County Rep.: [Signature]

**LAND CORNER RECORDATION CERTIFICATE**  
Filing Requirement of Act 74, Mich. P.A., 1970

For corners in

<u>Monroe</u> (County)	Located In:	Corner Code #
	<b>Dundee</b>	
1. Public Land Survey	T <u>6 S</u> R <u>6 E</u>	<u>E-5</u>
	T _____ R _____	_____
	T _____ R _____	_____
	T _____ R _____	_____
2. Property Controlling in Section	S _____ T _____ R _____	_____
	S _____ T _____ R _____	_____
3. Miscellaneous Property in Sec.	S _____ T _____ R _____	_____
	S _____ T _____ R _____	_____


RECEIVED FOR RECORD  
97 SEP 24 PM 3:34  
*[Signature]*  
REGISTER OF DEEDS  
MONROE COUNTY, MICH

**Register of Deeds Stamp & File Number**

4. Lot No. \_\_\_\_\_, Recorded Plat \_\_\_\_\_

5. Private Claims \_\_\_\_\_

I, Scott A. Warnke, in a field survey on June, 19 97 do hereby state that under requirements of P.A. 74, Michigan P.A. of 1970, the corner points mentioned in lines 1 and 2 above were in conformance with regulations and rules therefore as required in the current manual of survey instructions of the United States Department of the Interior, Bureau of Land Management or by decree of a Court of Law and / or that the corner points mentioned in lines 3, 4 and 5 above were in conformance with the rules of the Michigan Board of Land Surveyors or by a Decree of a Court of Law, established, re-established, monumented, recovered, found as expressed below:

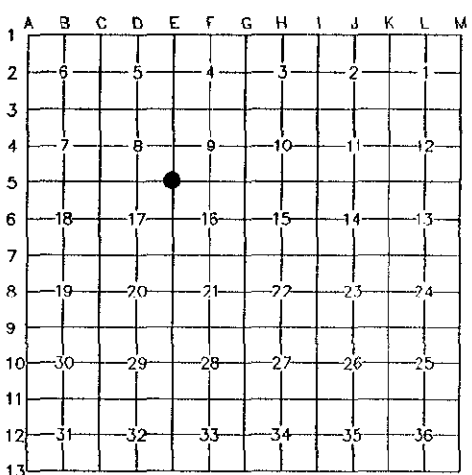

**NOTE:** Not more than 2 corners, all in the same town and range, may be recorded on this certificate.

Monroe County Road Commission Corner

**A. Description of original monument and accessories and/or subsequent restoration:**

- 1819 Joseph Fletcher set wood post: White Oak 9", S26°W, 11 links; White Ash 14", N28°W, 18 links.
- Aug. 1959 Marino found iron: West, 25.10' to square concrete post; East, 17.80' to 40" dead oak tree.
- Aug. 1960 A.J. Marino found iron pipe
- Sept. 1971 Norman N. Fahrner (L.C.R.C. L1, pg 13) found 1" iron pipe in gravel road:  
Westerly 26.2' to face of concrete fence post;  
N52°W, 32.4' to R.R. spike in wood fence post;  
N20°W, 87.4' to 8" locust;  
2' West of traveled center of Dennison Road.
- Jan. 1973 M.R. Fleck certified survey Liber 641 page 145 found 1/2" iron pipe
- April 1973 M.R. Fleck certified survey Liber 650 page 467 found iron pipe:  
N25°W, 86.72' to nail in 10" tree;  
West 24.92' to concrete corner post.
- September 1978 Werner Sommer used and found iron pipe.

**B. Description of corner evidence found and/or method applied in restoring or re-establishing corner:**

June 1997 found 3/4" iron pipe (top curled over) 12" below Tarby Road surface. Excavated a 2'x2'x2' deep hole around location of 3/4" iron pipe, did not find any other evidence in hole. However, from found 3/4" iron pipe, measured 32.4' ± and excavated hole to find the bottom of a fence post which was probably used in L.C.R.C., liber 1, page 13; also measured N20°W, ± 87' to find some old branches which may be from a locust tree used by Norman N. Fahrner (L.C.R.C., liber 1, page 13). Excavated area but could not find a definite tree stump. Found a capped iron rebar #12030, 32.98' West from found 3/4" iron pipe. Set 1" x 36" iron pipe in monument box at location of 3/4" iron pipe.

**C. Description of monument for corner and accessories established to perpetuate locating the position of the corner:**

- 1" x 36" Iron pipe with brass remonumentation disk in monument box.
- Witnesses: West, 32.98' to capped iron rebar #12080 18" below grade.  
N52°W, 32.20' to set railroad bolt in old wood fence post.  
N25°E, 43.28' to 3/4" iron rebar set 5' East of the East edge of pavement.  
S20°E, 32.96' to 3/4" iron rebar set 5' East of the East edge of pavement.  
South, 2641.70' to E-6, a 1"x36" Iron pipe with brass cap in monument box.

Signed by Scott A. Warnke  
Surveyor's Michigan License No. 41913

Date 9-8-97

