

**SURVEY &
REMONUMENTATION**

NOV 10 1997

COMMISSION

RATIFIED BY PEER GROUP
PA 345 OF 1990
MONROE COUNTY, MICHIGAN

date: 7/22/1997
County Rep.: [Signature]
For corners in

LAND CORNER RECORDATION CERTIFICATE
Filing Requirement of Act 74, Mich. P.A., 1970


RECEIVED FOR RECORD
97 SEP 24 PM 3:35
[Signature]
REGISTER OF DEEDS
MONROE COUNTY, MICH

Monroe <small>(County)</small>	Located In:	Corner Code #
	Dundee	
1. Public Land Survey	T <u>6</u> S R <u>6</u> E	<u>E-7</u>
	T _____ R _____	_____
	T _____ R _____	_____
	T _____ R _____	_____
2. Property Controlling in Section	S _____ T _____ R _____	_____
	S _____ T _____ R _____	_____
3. Miscellaneous Property in Sec.	S _____ T _____ R _____	_____
	S _____ T _____ R _____	_____

Register of Deeds Stamp & File Number

4. Lot No. _____, Recorded Plat _____

5. Private Claims _____

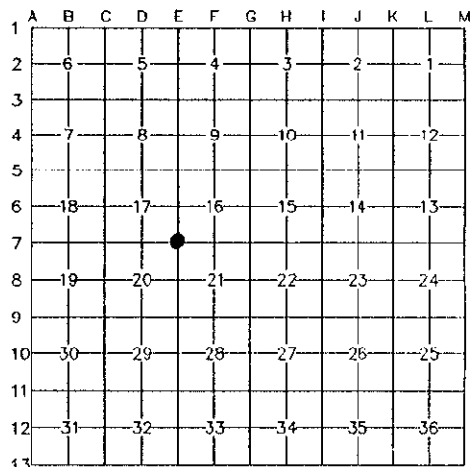

I, Scott A. Warnke, in a field survey on July, 19 97 do hereby state that under requirements of P.A. 74, Michigan P.A. of 1970, the corner points mentioned in lines 1 and 2 above were in conformance with regulations and rules therefore as required in the current manual of survey instructions of the United States Department of the Interior, Bureau of Land Management or by decree of a Court of Law and / or that the corner points mentioned in lines 3, 4 and 5 above were in conformance with the rules of the Michigan Board of Land Surveyors or by a Decree of a Court of Law; established, re-established, monumented, recovered, found as expressed below:

NOTE: Not more than 2 corners, all in the same town and range, may be recorded on this certificate.


Monroe County Road Commission Corner

- A. Description of original monument and accessories and/or subsequent restoration:
- 1819 Joseph Fletcher intersected a 9" Diameter corner tree;
 - July 5, 1975 G.B. Warnke L.P.S. #19474 Set Iron Pin in center of pile of stones 3.5' diameter.
 - S25°W, 47.34' to nail in East face of Utility pole;
 - S35°E, 61.12' to nail in West face of Power pole;
 - N20°E, 117.29' to nail in Westerly face of 20" Sycamore;
 - July 29, 1975 Same as above
 - August 1978 G.B. Warnke (L.C.R.C., Liber 2, Page 345) Set 5/8" Iron pin;
 - S25°W, 47.34' to nail in East face of Utility pole;
 - S35°E, 61.12' to nail in West face of Power pole;
 - N20°E, 117.29' to nail in Westerly face of 20" Sycamore;
 - June 1988 Glenn Richards Found Iron pipe.

- B. Description of corner evidence found and/or method applied in restoring or re-establishing corner:
- Excavated corner at location of found 3/4" Iron rod. Found 5 to 6 large stones (granite and limestone) in a 1.5' diameter circle around the 3/4" Iron rod. Excavated in center of stones but found no other evidence. Left stones in original locations and set a 1" x 30" Iron pipe with brass Remonumentation disk inside monument box at location of 3/4" Iron rod.

- C. Description of monument for corner and accessories established to perpetuate locating the position of the corner:
- 1" x 30" Iron pipe with brass Remonumentation disk in monument box;
- North, 159.78' to a "MAG" nail and M.C.R.C. tag in East face of power pole;
 - S30°E, 61.10' to nail & "Sunoco coin" in West face of power pole;
 - S20°W, 47.40' to "MAG" nail and M.C.R.C. tag in N.W. face of power pole;
 - N40°W, 116.71' to SE corner of block chimney to house #4019
 - Located at West edge of pavement of Dennison road at the intersection of Totten road;

Signed by Scott A. Warnke
Surveyor's Michigan License No. 41913

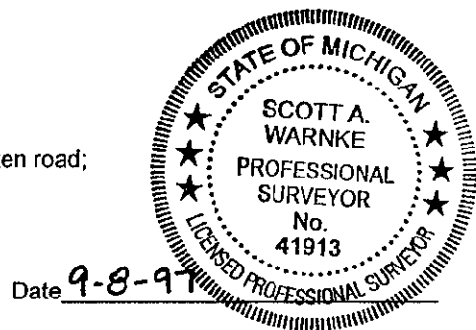

Date 9-8-97