

RATIFIED BY PEER GROUP
PA 345 OF 1990
MONROE COUNTY, MICHIGAN

date: 11/28/1995

LAND CORNER RECORDATION CERTIFICATE
Filing Requirement of Act 74, Mich. P.A. 1970

County Rep.: [Signature]
For corners in
Monroe (58)
(County)

Located In: _____ Corner Code #/

- | | | |
|---------------------------------------|--|--|
| 1. Public Land Survey
Dundee Twp. | T _____ R _____
T <u>6S</u> R <u>6E</u>
T _____ R _____
T _____ R _____ | _____ <u>M-3</u> _____

_____ |
| 2. Property Controlling
in Section | S _____ T _____ R _____
S _____ T _____ R _____ | _____ |
| 3. Miscellaneous
Property in Sec. | S _____ T _____ R _____
S _____ T _____ R _____ | _____ |

**SURVEY &
REMONUMENTATION**

Register of Deeds Stamp & File Number

APR 04 1996

COMMISSION

	A	B	C	D	E	F	G	H	I	J	K	L
2	6	5	4	3	2	1						
3												
4	7	8	9	10	11	12						
5												
6	18	17	16	15	14	13						
7												
8	19	20	21	22	23	24						
9												
10	30	29	28	27	26	25						
11												
12	31	32	33	34	35	36						
13												

1995 REMONUMENTATION PROGRAM

I, G.B. WARNKE, JR., in a field survey on Nov.-Dec., 1995, 19____, do hereby certify that under requirements of P.A. 74, Michigan P.A. of 1970, the corner points mentioned in lines 1 and 2 above were in conformance with regulations and rules therefore as required in the current manual of survey instructions of the United States Department of the Interior, Bureau of Land Management or by a decree of a Court of Law and/or that the corner points mentioned in lines 3, 4 and 5 above were in conformance with the rules of the Michigan Board of Land Surveyors or by a Decree of a Court of Law; established, re-established, monumented, re-monumented, recovered, found as expressed below:

NOTE: Not more than 4 corners, all in the same town and range, may be recorded on this certificate.

A. Description of original monument and accessories and/or subsequent restoration:

Section Corner common to Sections 1 & 12 on east township line / On Radka Road (gravel surface) being +/- 445' east of Dundee-Azailia Road (not common to A-3, T6S, R7E) 1819, GLO Surveyor, J. Fletcher, set post cor. of Sect. 1 & 12 - witnesses: W. Oak 18 N.29E. 24 lks. & W. Oak 15 S.85W. 8 lks. 1829, GLO Surveyor, Robert Clark, Jr. used corner. 1957, Atwell - Hicks, Job #1124-S, set concrete monument with iron. 1983, G.B. Warnke, Job #83-420-A, FD. MON. 1991, G.B. Warnke recorded LCRC, Liber 3, Page 153, to FOUND CONCRETE MONUMENT as set by Atwell-Hicks. 1991, James H. Miller, Job #91 12.297, FND. 1/2" IRON IN 4" CONC.

B. Description of corner evidence found and/or method applied in restoring or reestablishing corner:


11/1995, G.B. Warnke crew located point and checked witnesses as shown below. 11/28/1995 - corner was Peer Group approved. 12/7/1995 - cut 7 inches off top of 3/4 inch (I.D.) iron pipe in concrete and drove 1/2 inch x 10 inch rebar into said found pipe and set brass remonumentation cap on rebar (cap is approximately 7 inches below gravel road). Found 5" x 3" granite stone 0.4 feet east of 3/4 inch iron pipe at 5 inches below gravel roadway.

C. Description of monument for corner and accessories established to perpetuate locating the position of the corner:

Set 1/2" x 10" rebar with brass remonumentation cap inside found 3/4" (I.D.) iron pipe in 4" concrete monument & is accepted as the best available evidence of the position of the original corner & witnesses: Found stone being 0.3' east
North 01°28' East 18.57 feet to found concrete monument for NW corner of Sec. 7, T6S, R7E (A-3)
North 75° West 54.77 feet to SE corner of concrete wing wall
North 05° West 35.13 feet to nail/shiner in east face of electric pole
North 40° East 43.26 feet to nail/shiner in south face of electric pole
+/- center of road

Signed by [Signature]
Surveyor's Michigan License No. 19474

Date 12/19/1995

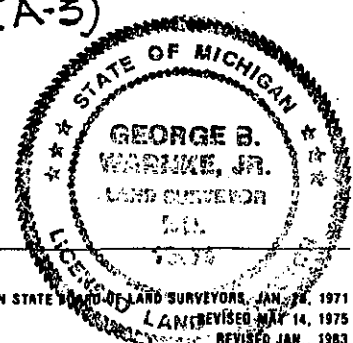

FORM APPROVED BY MICHIGAN STATE BOARD OF LAND SURVEYORS, JAN. 28, 1971
LAND SURVEYOR
REVISED JAN., 1983

⑧ M-3, T6S, R6E, DUNDEE TWP.