

RATIFIED BY PEER GROUP  
PA 345 OF 1990  
MONROE COUNTY, MICHIGAN

date: 11/28/1995

County Rep.: [Signature]

For corners in  
Monroe (58)  
(County)

**LAND CORNER RECORDATION CERTIFICATE**  
Filing Requirement of Act 74, Mich. P.A. 1970

RECEIVED FOR RECORDS  
95 DEC 28 AM 9:04  
[Signature]  
REGISTER OF DEEDS  
MONROE COUNTY, MICHIGAN

	Located In:	Corner Code #
1. Public Land Survey DUNDEE Twp.	T <u>6S</u> R <u>6E</u>	<u>M-5</u>
2. Property Controlling in Section	S <u>   </u> T <u>   </u> R <u>   </u>	<u>   </u>
3. Miscellaneous Property in Sec.	S <u>   </u> T <u>   </u> R <u>   </u>	<u>   </u>

**SURVEY & REMONUMENTATION**

Register of Deeds Stamp & File Number

APR 04 1996

4. Lot No. \_\_\_\_\_, Recorded Plat \_\_\_\_\_  
5. Private Claims \_\_\_\_\_

COMMISSION

	A	B	C	D	E	F	G	H	I	J	K	L
2	6	5	4	3	2							
3												
4	7	8	9	10	11							
5												
6	18	17	16	15	14							
7												
8	19	20	21	22	23							
9												
10	30	29	28	27	26							
11												
12	31	32	33	34	35							
13												

1995 REMONUMENTATION PROGRAM

I, G.B. WARNKE, JR., in a field survey on Nov-Dec, 1995, 19\_\_\_\_, do hereby certify that under requirements of P.A. 74, Michigan P.A. of 1970, the corner points mentioned in lines 1 and 2 above were in conformance with regulations and rules therefore as required in the current manual of survey instructions of the United States Department of the Interior, Bureau of Land Management or by a decree of a Court of Law and/or that the corner points mentioned in lines 3, 4 and 5 above were in conformance with the rules of the Michigan Board of Land Surveyors or by a Decree of a Court of Law; established, re-established, monumented, re-monumented, recovered, found as expressed below:

NOTE: Not more than 4 corners, all in the same town and range, may be recorded on this certificate.

A. Description of original monument and accessories and/or subsequent restoration:

Section Corner common to Sections 12 & 13 / On Rogers Road (stone surface) being east of Dundee - Azalia Road (not common to A-5, T6S, R7E)  
1819 or 1829, GLO Surveyor, J. Fletcher or Robert Clark, Jr., set post cor. of Secs. 12 & 13 - witnesses: R. Oak 24 S41E 11 lks. & Lynn 8 S.71W. 11 lks. 1971, Case & Fleck survey #15297 notes corner but not material. 1977, Case & Fleck survey #19724 notes S.I.P. 1983, G.B. Warnke survey #83-420-A notes RD. PINCHED IRON. 1986, G.B. Warnke survey #86-229, recorded in Liber 967, Page 187, notes REPLACED OLD IRON FOUND WITH 3/4" I. PIPE & BRICKS. 1989, G.B. Warnke survey #89-137 notes FD. PINCHED IRON. 1990, G.B. Warnke recorded in LCRC Liber 3, Page 147, to FOUND PINCHED IRON PIPE.


B. Description of corner evidence found and/or method applied in restoring or reestablishing corner:

11/10/95 - G.B. Warnke crew found corner & checked witnesses. 11/28/95 - corner was Peer Group approved. 12/7/95 - excavated in area of found 3/4" x 22" pinched iron pipe driven through 3 bricks and found two more bricks on north & south sides of pipe. At bottom of hole when pinch pipe ended, found 1/2" (O.D.) x 10" old iron pipe. Dug to a depth of 2.5 feet x 2 foot diameter hole and probed; no further evidence found. Left pinch pipe & 1/2" iron pipe at bottom of hole and set 1" x 36" iron pipe with brass remonumentation cap and set bricks along side of pipe. Cap is +/- 6" below existing ground. Point is +/- 2 feet north of north top of road ditch. (Note: previously witnessed tree being 6+ feet away is now gone.)

C. Description of monument for corner and accessories established to perpetuate locating the position of the corner:

Set 1" x 36" iron pipe with brass remonumentation cap and is accepted as the best available evidence of the position of the original corner and witnesses:  
North 01°30' East 34.60 feet to found stone for NW corner, Sec. 18, T6S, R7E (A-5)  
1.9 feet West & 14.5 feet North to found iron pipe in center line of road  
North 5.2 feet to south edge of Rogers Road  
North 30° West 55.22 feet to car coin & nail (3 feet above ground) in southerly face of telephone pole  
North 88°25' West 439.29 feet to found 1/2" (I.D.) iron pipe at centerline of Dundee-Azalia Road & Rogers Road (2" below asphalt pavement)

Signed by [Signature] Date 12/19/1995  
Surveyor's Michigan License No. 19474

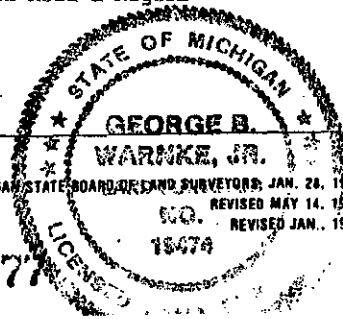

(12) M-5 (6/6) Dundee