

RATIFIED BY PEER GROUP  
 PA 345 OF 1890  
 MONROE COUNTY, MICHIGAN  
 date: 11/28/1995  
 County Rep.: [Signature]

LAND CORNER RECORDATION CERTIFICATE  
 Filing Requirement of Act 74, Mich. P.A. 1970

RECEIVED FOR RECORDS  
 95 DEC 22 AM 9:04

For corners in Monroe (58) (County)	Located In:	Corner Code #
1. Public Land Survey DUNDEE Twp.	T <u>6S</u> R <u>7E</u>	<u>A-4</u>
2. Property Controlling in Section	S <u>   </u> T <u>   </u> R <u>   </u>	<u>SURVEY &amp;</u>
3. Miscellaneous Property in Sec.	S <u>   </u> T <u>   </u> R <u>   </u>	<u>REMONUMENTATION</u>

Register of Deeds Stamp & File Number

4. Lot No. \_\_\_\_\_, Recorded Plat APR 04 1996  
 5. Private Claims \_\_\_\_\_

COMMISSION

1995 REMONUMENTATION PROGRAM

	A	B	C	D	E	F	G	H	I	J	K	L
2	6	5	4	3	2	1						
3												
4	7	8	9	10	11	12						
5												
6	18	17	16	15	14	13						
7												
8	19	20	21	22	23	24						
9												
10	30	29	28	27	26	25						
11												
12	31	32	33	34	35	36						
13												

I, G.B. WARNKE, JR., in a field survey on Nov.-Dec., 1995, 19\_\_\_\_, do hereby certify that under requirements of P.A. 74, Michigan P.A. of 1970, the corner points mentioned in lines 1 and 2 above were in conformance with regulations and rules therof as required in the current manual of survey instructions of the United States Department of the Interior, Bureau of Land Management or by a decree of a Court of Law and/or that the corner points mentioned in lines 3, 4 and 5 above were in conformance with the rules of the Michigan Board of Land Surveyors or by a Decree of a Court of Law, established, re-established, monumented, re-monumented, recovered, found as expressed below:

**NOTE: Not more than 4 corners, all in the same town and range, may be recorded on this certificate.**

A. Description of original monument and accessories and/or subsequent restoration:

1/4 Corner common to Section 7 on west township line. / On Lafler Road (gravel surface).  
 (approved as common to M-4, T6S, R6E)  
 Not set by G.L.O. 1958, Detroit Edison field notes show FD. STONE. 1991, G.B. Warnke recorded LCRC, Liber 3, Page 154, to FOUND STONE (placed railroad spikes around stone) using Detroit Edison notes.


B. Description of corner evidence found and/or method applied in restoring or reestablishing corner:

11/10/95 - G.B. Warnke crew found 3/4" iron pipe being 6.95 feet northwest from stone (used as A-4, T6S, R7E). 2 near witnesses ok to stone. Stones & bricks are around & under stone. Stone was 15" long x 7-8" in diameter and point on top. Found a 3 inch triangular black area from 21 to 25 inches deep being almost directly under main stone. Set 1" x 36" iron pipe in dark spot and layed main stone on west side and other stones and bricks surrounding iron. 11/28/95 - corner approved by Peer Group. 12/7/95 - set brass remonumentation cap in previously set 1" x 36" iron pipe and witnessed as shown below.

C. Description of monument for corner and accessories established to perpetuate locating the position of the corner:

Set 1" x 36" iron pipe with brass remonumentation cap and this position not established by original government surveyors and this monument is accepted as the best available evidence of the position of the corner and witnesses:  
 Found 3/4" iron pipe being 3.6 feet north & 4.9 feet west  
 West +/- 438.5 feet to centerline of Dundee - Azalia Road  
 South 88°35' East 2550.12 feet to found 3/4" iron pipe for center, Sec. 7, T6S, R7E (B-4)  
 South 20° West 19.50 feet to nail/shiner in easterly face of guy pole  
 North 25° West 34.67 feet to nail/shiner in easterly face of electric pole  
 South 60° West 44.46 feet to northwesterly face of northerly metal post for railroad crossing

Signed by [Signature] Date 12/19/1995  
 Surveyor's Michigan License No. 19474

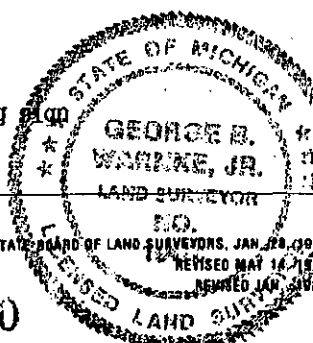

⑤ A-4, T6S, R7E, DUNDEE TWP. 4 PAGE 80