

REMONUMENTATION

MAY 20 1997

COMMISSION

LAND CORNER RECORDATION CERTIFICATE
Filing Requirement of Act 74, Mich. P.A., 1970

RECEIVED

96 DEC 13 PM 3:15

Handwritten signature and stamp

For corners in

Monroe

(County)

Located In:

Corner Code #

Dundee Twp.

T 6S R 7E

E-9

1. Public Land Survey

T R

T R

T R

2. Property Controlling in Section

S T R

S T R

3. Miscellaneous Property in Sec.

S T R

S T R

Register of Deeds Stamp & File Number

4. Lot No. , Recorded Plat

5. Private Claims

I, Bruce Antcliff, in a field survey on August, 1996 do hereby state that under requirements of P.A. 74, Michigan P.A. of 1970, the corner points mentioned in lines 1 and 2 above were in conformance with regulations and rules therefore as required in the current manual of survey instructions of the United States Department of the Interior, Bureau of Land Management or by decree of a Court of Law and / or that the corner points mentioned in lines 3, 4 and 5 above were in conformance with the rules of the Michigan Board of Land Surveyors or by a Decree of a Court of Law; established, re-established, monumented, recovered, found as expressed below:

NOTE: Not more than 2 corners, all in the same town and range, may be recorded on this certificate.

Monroe County Road Commission Corner

A. Description of original monument and accessories and/or subsequent restoration:

- Section corner common to Sections 20, 21, 28 & 29, T6S, R7E / Eggert & Meanwell Roads, Asphalt over stone. 1819, GLO Surveyor Fletcher set wood post; BO 10", S38E, 20 Inks; Do 10", S41W, 44 Inks. 1966, MCRC witness card, found 1/2" iron rod 1972, Kenneth Suydam found 5/8" iron rod, LCRC L1, P95 1972, Case & Fleck survey, found iron rod, L623, P996 1976, M.R.Fleck survey, found iron rod, L712, P467 1976, Jack Erickson found iron, LCRC L2, P158 1987, MCRC found I.P., N45E, 87.16', PK/Shiner S. root of 26" oak; N70E, 61.10', PK/Shiner SW root of 24" oak; S55E, 65.37', PK/Shiner N side of 20" hickory; S62W, 60.93', PK/Shiner NE side of 15" oak . 1988, M.R.Fleck survey, found I.P., L1050, P533 1990, J.C.Andrus survey, two surveys, found iron rod 1990, G.B.Warnke field notes, survey #90-326, found 1/2" iron rod, S60E, 65.39', Nail/shiner N face 20" hickory; N70E, 63.56', Nail/shiner N face 24" oak; S75W, 60.94', PK in NW face 10" oak; S45E, 46.98', Nail/shiner in wood fence corner

B. Description of corner evidence found and/or method applied in restoring or re-establishing corner:

No iron found. Swung MCRC witnesses and excavated 2'x2'x30" deep. Found a 5/8" discoloration in yellow sand. This spot fits the witnesses. A second discoloration was found 0.3' south & 0.3' east of witnesses. Irons were probably destroyed during paving project. No other evidence was found.

C. Description of monument for corner and accessories established to perpetuate locating the position of the corner:


Set 1" x 36" iron pipe with brass remonumentation cap inside monument box at witnessed location and is accepted as the best evidence of the position of the original corner.

Witnesses:

- N54E, 43.05', 16d nail/lg shiner S face of 18" oak N73E, 63.53', duplex nail/shiner S face of 30" oak S56E, 66.56', duplex nail/shiner N face of 20" hickory S50W, 45.44', nail/shiner E face of 5" dia. post S68W, 60.91', PK nail/shiner NE face of 20" oak

RATIFIED BY PEER GROUP PA 345 OF 1990 MONROE COUNTY, MICHIGAN

date: 8/27/1996 County Rep.: [Signature]

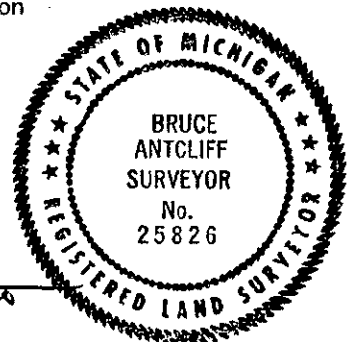

Signed by

[Signature of Bruce Antcliff]

Date

11-13-96

Surveyor's Michigan License No. 25826