

# SURVEY & REMONUMENTATION

FEB 13 1998

## SECTION

### LAND CORNER RECORDATION CERTIFICATE Filing Requirement of Act 74, Mich. P.A., 1970

For corners in

MONROE (58)  
(County)

Located In:

Corner Code #

**RAISINVILLE & DUNDEE TWP.**

1. Public Land Survey	T <u>6S</u> R <u>7E</u>	<u>G-2</u>
	T _____ R _____	_____
	T _____ R _____	_____
	T _____ R _____	_____
2. Property Controlling in Section	S _____ T _____ R _____	_____
	S _____ T _____ R _____	_____
3. Miscellaneous Property in Sec.	S _____ T _____ R _____	_____
	S _____ T _____ R _____	_____

RECEIVED FOR RECORD  
 97 DEC 30 PM 3:35  
 HONORABLE CLERK  
 REGISTER OF DEEDS  
 MONROE COUNTY, MICH.


Register of Deeds Stamp & File Number

4. Lot No. \_\_\_\_\_, Recorded Plat \_\_\_\_\_

5. Private Claims \_\_\_\_\_

1997 Remonumentation Program Corner

I, George B. Warnke, Jr., in a field survey on September - December, 1997 do hereby state that under requirements of P.A. 74, Michigan P.A. of 1970, the corner points mentioned in lines 1 and 2 above were in conformance with regulations and rules therefore as required in the current manual of survey instructions of the United States Department of the Interior, Bureau of Land Management or by decree of a Court of Law and / or that the corner points mentioned in lines 3, 4 and 5 above were in conformance with the rules of the Michigan Board of Land Surveyors or by a Decree of a Court of Law; established, re-established, monumented, recovered, found as expressed below:

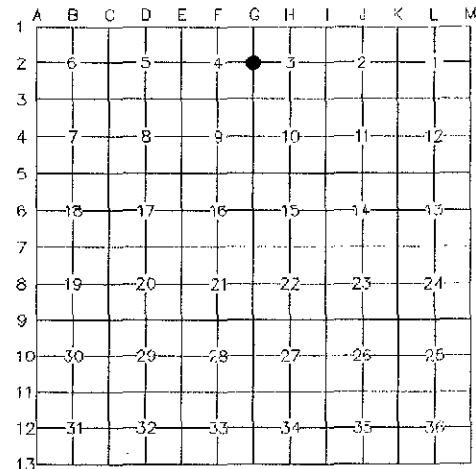

**NOTE: Not more than 2 corners, all in the same town and range, may be recorded on this certificate.**

**A. Description of original monument and accessories and/or subsequent restoration:**

- 1819 GLO Surveyor, J. Fletcher, set 1/4 Sec. post - witnesses: W. Oak 16 S15W 36 & W. Oak 12 S41W 48
- 1964 Case & Fleck survey (#6257 ?) notes East Quarter Corner of Sec. 4 (no material or witnesses)
- 1973 Case & Fleck survey (#17380), recorded in Liber 650, Page 298 & Liber 650, Page 465, notes NE cor. of SE 1/4, Sec. 4 - S IP. & Cap - witnesses:  
 S.45°E. 41.17' to nail 18" Oak  
 East 10.65' to nail 30" Walm  
 North 28.10' to nail 10" Oak
- 1975 Angelo Marino field notes show E1/4 cor. Sec. 4 (no material or witnesses)
- 1977 George Warnke field notes (77-146) shows Fd. 3/4" l. pipe & cap #6193 - witnesses:  
 S45°E 41.17' nail 18" Oak W'ly face  
 East 10.56' nail 24" Oak S'ly face  
 North 28.10' nail 10" Oak E'ly face  
 South 1007' +/- fd. pinch pipe  
 South 1455' +/- fd. pinch pipe
- 1982 George Warnke survey (82-118), recorded in Liber 865, Page 893, notes East 1/4 cor. Sec. 4 - Iron pipe & cap #6193 in center of post base - remains of brick 15" deep - (2 witnesses the same as Case & Fleck in 1973) witnesses:  
 S45°E 41.17' nail in W'ly face 18" Oak  
 East 10.56' nail in S'ly face 24" Oak  
 North 28.10' nail in E'ly face 10" Oak
- 1992 George Warnke survey (92-0176), recorded in Liber 1237, Page 0389, notes East Quarter Corner Section 4,

**B. Description of corner evidence found and/or method applied in restoring or re-establishing corner:**

1997, G.B. Warnke crew found iron pipe and checked witnesses. Set 1" x 36" pipe with brass remonumentation cap over found pipe. Location of corner is in woods by Dundee gun range.


**RATIFIED BY PEER GROUP, PA 345 OF 1990, MONROE COUNTY, MICHIGAN, DATE 7/22/1997, COUNTY REP.**

**C. Description of monument for corner and accessories established to perpetuate locating the position of the corner:**

Set 1" x 36" pipe with brass remonumentation cap over found pipe and is accepted as the best available evidence of the position of the original corner. Witnesses:  
 South 45° East 41.47 feet to reset nail & remonumentation shiner in westerly face of 18" Oak  
 East 10.56 feet to reset nail & remonumentation shiner in southerly face of 24" Oak  
 North 28.10 feet to reset nail & remonumentation shiner in easterly face of 10" Oak  
 West 24.25 feet to set nail & remonumentation shiner in easterly face of 18" Maple

Signed by \_\_\_\_\_  
 Surveyor's Michigan License No. 19474

Date December 17, 1997

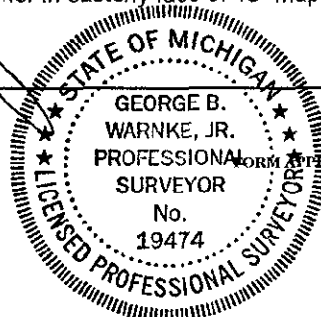

FORM APPROVED BY MICHIGAN STATE BOARD OF LAND SURVEYORS, JAN. 28, 1971  
 REVISED MAY 14, 1972  
 REVISED JAN., 1981  
 REVISED OCT., 1991