

NOTIFIED BY PEER GROUP
 PA 345 OF 1990
 MONROE COUNTY, MICHIGAN
 date: 8/29/95
 County Rep. [Signature]

LAND CORNER RECORDATION CERTIFICATE
 Filing Requirement of Act 74, Mich. P.A. 1970

For corners in

Monroe (County) Located In: Corner Code #

1. Public Land Survey Raisinville Twp. T 6S R 7E I-13

2. Property Controlling in Section S T R

3. Miscellaneous Property in Sec. S T R

RECEIVED FOR RECORD
 95 DEC 29 AM 9:00
 [Signature]

SURVEY & REMONUMENTATION

Register of Deeds Stamp & File Number

4. Lot No. _____ Recorded Plat _____
 5. Private Claims _____ APR 04 1996

G.B. Warnke & Monroe Co. Road Commission Corner
 Bruce Antcliff 12/22 95
 I. G.B. Warnke in a field survey on 3/10 1995 do hereby state that under requirements of P.A. 74, Michigan P.A. of 1970, the corner points mentioned in lines 1 and 2 above were in conformance with regulations and rules therefore as required in the current manual of survey instructions of the United States Department of the Interior, Bureau of Land Management or by a decree of a Court of Law and/or that the corner points mentioned in lines 3, 4 and 5 above were in conformance with the rules of the Michigan Board of Land Surveyors or by a Decree of a Court of Law; established, re-established, monumented, recovered, found as expressed below:

COMMISSION

NOTE: Not more than 2 corners, all in the same town and range, may be recorded on this certificate.

	A	B	C	D	E	F	G	H	I	J	K	L
1												
2	6		5		4		3		2		1	
3												
4	7		8		9		10		11		12	
5												
6	18		17		16		15		14		13	
7												
8	19		20		21		22		23		24	
9												
10	30		29		28		27		26		25	
11												
12	31		32		33		34		35		36	
13												

A. Description of original monument and accessories and/or subsequent restoration:

I-13, Ida EW at Lewis Ave., Asphalt Pavement
 1815, GLO Surveyor Alex Holmes set post corner Sections 34 & 35, Witnessed W. Oak 15 inch South 62o East 52 links, W. Oak 18 inch North 77o West 87 links. 1849, GLO Surveyor Orange Risdon on resurvey set post 4.57 chains south of south line of claim 683. Peter-Lester Addition to Village of Ida (Liber 3, Page 55) and Wolf Plat (Liber 6, Page 50) both used this corner as the starting point. 1961, A.J. Marino found PK Nail. 1972, M.R. Fleck found a PK and recorded in MCRC, Liber 1, Page 185 & 186. 1980, A.J. Marino place PK nail at corner, based on monumentation of Wolf Plat. 1980's sanitary sewer construction down the centerline of Lewis Ave. & Ida East Road destroyed evidence of corners. 10-4-94, G.B. Warnke found PK Nail at corner (also found RR spike 11.34 east in the centerline of pavement of Lewis Ave. - 1948 MSDH field notes show a distance of 11.71 feet between centerline of pavement and section corner.

B. Description of corner evidence found and/or method applied in restoring or reestablishing corner:

3/10/95, using monumentation from Wolf Plat (Liber 6 of Plats, Page 50) PK nail found by G.B. Warnke on 10-4-1994 fits the plat as the southeast corner of Section 34. Replaced PK nail with PK nail & washer.


C. Description of monument for corner and accessories established to perpetuate locating the position of the corner:

Set 1 inch x 36 inch iron pipe with brass remonumentation cap inside monument box to replace PK nail & washer and is accepted as the best available evidence of the position of the original corner.

Witnesses:
 North 62° East 50.14 feet to nail/shiner in SW face of util. Pole.
 North 18° West 92.02 feet to ESE corner of funeral home.
 South 32° West 93.18 feet to NE corner of block building, metal edge.
 South 20° West 48.98 feet to PK nail/shiner in NE face of light pole.
 South 36° East 56.25 feet to PK nail/shiner in NW face of guy pole.
 East 11.30 feet to I-1, T7S, R7E, brass remon cap in mon box.

Signed by Bruce Antcliff
 Surveyor's Michigan License No. 25826

Date 12-27-95

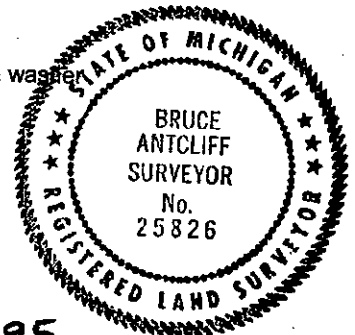

32 I-13, T6S, R7E
 RAISINVILLE