

**RATIFIED BY PEER GROUP**  
 PA 345 OF 1990  
 MONROE COUNTY, MICHIGAN

date: 10/24/95  
 County Rep. [Signature]

**LAND CORNER RECORDATION CERTIFICATE**  
 Filing Requirement of Act 74, Mich. P.A. 1970

For corners in Monroe (58) (County)	Located In:	Corner Code #
1. Public Land Survey FRENCHTOWN TWP.	T <u>6S</u> R <u>9E</u>	B-2
2. Property Controlling in Section	S <u>   </u> T <u>   </u> R <u>   </u>	
3. Miscellaneous Property in Sec.	S <u>   </u> T <u>   </u> R <u>   </u>	

REGISTERED FOR RECORD  
 95 DEC 28 AM 9:57

**SURVEY & REMONUMENTATION** Register of Deeds Stamp & File Number

4. Lot No. \_\_\_\_\_, Recorded Plat APR 04 1996  
 5. Private Claims \_\_\_\_\_

Submitted by George B. Warnke, Jr., P.S. / M.C.R.C. Project **COMMISSION**

I, G.B. WARNKE, JR., in a field survey on 1993 - 1995, 19\_\_\_\_, do hereby certify that under requirements of P.A. 74, Michigan P.A. of 1970, the corner points mentioned in lines 1 and 2 above were in conformance with regulations and rules therefore as required in the current manual of survey instructions of the United States Department of the Interior, Bureau of Land Management or by a decree of a Court of Law and/or that the corner points mentioned in lines 3, 4 and 5 above were in conformance with the rules of the Michigan Board of Land Surveyors or by a Decree of a Court of Law; established, re-established, monumented, re-monumented, recovered, found as expressed below:

**NOTE: Not more than 4 corners, all in the same town and range, may be recorded on this certificate.**

	A	B	C	D	E	F	G	H	I	J	K	L
2	1	2	3	4	5	6	7	8	9	10	11	12
3												
4	7	8	9	10	11	12						
5												
6	13	14	15	16	17	18						
7												
8	19	20	21	22	23	24						
9												
10	25	26	27	28	29	30						
11												
12	31	32	33	34	35	36						
13												

**A. Description of original monument and accessories and/or subsequent restoration:**

Center of Section 6 / Intersection of Toben Road & Reinhardt Road - hard surface  
 Not set by G.L.O. A.J. Marino: 1953 - F.I.P., 1954 - F. Pipe, 1955 - F.I.P., 1956, Fd.I.P., 1963 - F.I., 1964 - F.I., 1969 - F.I., 1972 - could not locate point, 1977 - notes "Center of Sec. (F. old iron pipe)" & references "Found R.R. Spike (0.71' N & 0.33' W)" & "Found Bent Iron Rod (2.87' East)", 1982 - found 3/4" rebar (no other ref's). 1967, Detroit Edison survey by J. Macay notes Fd. Rod. M.R. Fleck: 1969 - notes "old I.P." & steel rod, 1972 - recorded LCRC, Liber 1, Page 203, to "found RR. Spike set in 1970 (2.87' west of steel rod & 0.65' north of IP.) & reference surveys recorded in Liber 636, Page 184 & Liber 650, Page 487, which notes Found R.R. Spike at intersection of 1/4 lines & Liber 654, Page 264, 1979 - recorded survey, Liber 794, Page 586, to Found Iron (no other ref's). G.B. Warnke: 1990 - found R.R. spike per LCRC

continued in B

**B. Description of corner evidence found and/or method applied in restoring or reestablishing corner:**

continued from A  
 & references found bolt 2.87' east & Found I. pipe 0.65' south, 1993 - found 1/2" x 24" rebar & references south 0.65' fd. 1/2" rebar & East 2.87' fd. 1/2" rebar & S50°W 7.22' fd. 3/4" pipe, which were pulled. 1993, J.C. Andrus "Fd. iron pin".



1993 - found 1/2" x 24" rebar and references south 0.65' fd. 1/2" rebar & East 2.87' fd. 1/2" rebar & S50°W 7.22' fd. 3/4" pipe, which were pulled by Warnke crew. 1994 - Monroe County Road Commission set monument box. 1995 - Warnke set 1" x 36" iron pipe in monument box to replace found 1/2" x 24" rebar.

**C. Description of monument for corner and accessories established to perpetuate locating the position of the corner:**

& remon comp

Set 1" x 36" iron pipe in monument box to replace found 1/2" x 24" rebar and this position not established by original government surveyors. This monument is accepted as the best available evidence of the position of the corner and witnesses:

- North 30° East 86.77 feet to set nail/shiner in south face of 9" Elm tree
- North 45° East 46.41 feet to found 3/4" iron pipe at right-of-way
- South 50° East 105.17 feet to set nail/shiner in west face of 8" Elm tree
- South 45° East 60.70 feet to set T hub
- North 45° West 49.24 feet to set T hub

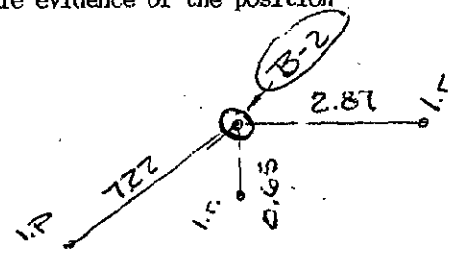

Signed by [Signature] Date 12/27/1995

Surveyor's Michigan License No. 19474

Corner submitted by G.B. Warnke, Jr., P.S.