

date: 4/19/96

County Rep.: \_\_\_\_\_ **LAND CORNER RECORDATION CERTIFICATE**  
Filing Requirement of Act 74, Mich. P.A. 1970

RECORDED FOR RECORD  
95 SEP -6 PM 1:45

For corners in  
MONROE  
(County)

	Located in:	Corner Code #:
1. Public Land Survey FRENCHTOWN TOWNSHIP	T _____ R _____ T <u>6S</u> R <u>9E</u> T _____ R _____ T _____ R _____	_____ <u>C-3</u> _____
2. Property Controlling in Section	S _____ T _____ R _____ S _____ T _____ R _____	_____ _____
3. Miscellaneous Property in Sec.	S _____ T _____ R _____ S _____ T _____ R _____	_____ _____

*Handwritten Signature*  
REGISTER OF DEEDS  
MONROE COUNTY, MICHIGAN


Register of Deeds Stamp & File Number

4. Lot No. \_\_\_\_\_, Recorded Plat \_\_\_\_\_  
5. Private Claims \_\_\_\_\_

**GEORGE B. WARNKE CORNER**

I, G.B. WARNKE, JR., in a field survey on 1995 & 1996, 19 \_\_\_\_\_, do hereby certify that under requirements of P.A. 74, Michigan P.A. of 1970, the corner points mentioned in lines 1 and 2 above were in conformance with regulations and rules therefore as required in the current manual of survey instructions of the United States Department of the Interior, Bureau of Land Management or by a decree of a Court of Law and/or that the corner points mentioned in lines 3, 4 and 5 above were in conformance with the rules of the Michigan Board of Land Surveyors or by a Decree of a Court of Law; established, re-established, monumented, re-monumented, recovered, found as expressed below:

**NOTE: Not more than 4 corners, all in the same town and range, may be recorded on this certificate.**

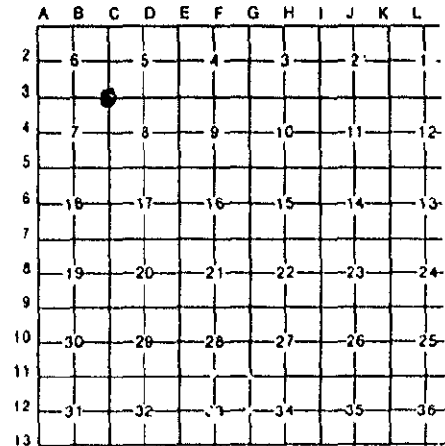

**A. Description of original monument and accessories and/or subsequent restoration:**

Section Corner common to Sections 5, 6, 7 & 8 - not on road, being westerly of Steiner Road 1847, GLO Surveyor Orange Risdon, set post corner of Sections 5,6,7 & 8 - witnesses:  
W. Oak 10 inch, N 74° West 55 links & B. Oak 12 inch, South 109 links.  
Old R.R. map, date unknown, shows north line of R.R. right-of-way is on Section line, no monumentation mentioned.  
1969, A.J. Marino found new post at intersection of old fences.  
1976, M.R. Fleck set iron pipe in center of post stub per Case & Fleck Survey (#19270). 1977, A.J. Marino, found capped iron pipe (Case & Fleck).  
1986, G.B. Warnke found capped iron pipe (#6193).

**B. Description of corner evidence found and/or method applied in restoring or reestablishing corner:**

April 11, 1995, found capped 3/4 inch iron pipe (#6193), found a 4' x 30" stump, 22 feet North 80° West of iron as called out in Case & Fleck's 1976 survey. Probed in a 6 foot diameter circle around iron, did not find stone. Dug around iron and found remains of a fence post.  
7/31/1996, set 1" x 36" iron pipe with brass remonumentation cap over found 3/4" iron pipe & witnessed as shown below.

**SURVEY & REMONUMENTATION**

DEC 16 1996


**COMMISSION**

RATIFIED BY PEER GROUP  
PA 345 OF 1990  
MONROE COUNTY, MICHIGAN  
date: 4/19/96  
County Rep.: \_\_\_\_\_

**C. Description of monument for corner and accessories established to perpetuate locating the position of the corner:**

Set 1" x 36" iron pipe over found 3/4 inch capped iron pipe (#6193) and is accepted as the best available evidence of the position of the original corner and witnesses:  
South 61.75 feet to a set nail/tag west face of northerly 18" multiple truck Oak  
South 30° West 54.77 feet to a set nail/tag in north face of 24" Oak  
East 38.55 feet to set nail/tag in south face of 8" Oak  
West 64.87 feet to set nail/tag in east face of 18" Oak  
North 85° West 22 feet to east face of 4' tall 30" stump  
East 5.8 feet to centerline of 6" diameter fence post (fence to south, east & west)

Signed by [Signature] Date 8/22/1996  
Surveyor's Michigan License No. 19474

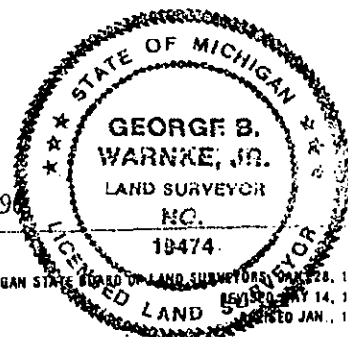

FORM APPROVED BY MICHIGAN STATE BOARD OF LAND SURVEYORS, JAN. 28, 1978  
REVISED MAY 14, 1981  
REVISED JAN., 1991