

SECTION

LAND CORNER RECORDATION CERTIFICATE  
Filing Requirement of Act 74, Mich. P.A., 1970

For corners in MONROE (58)  
(County)

Located In: FRENCHTOWN TWP. Corner Code # H-7

1. Public Land Survey T 6 S R 9 E

2. Property Controlling in Section S T R

3. Miscellaneous Property in Sec. S T R

4. Lot No. \_\_\_\_\_, Recorded Plat \_\_\_\_\_

5. Private Claims \_\_\_\_\_

RECEIVED FOR RECORD  
99 OCT 14 AM 9:25  
*Leslie Allen*  
REGISTER OF DEEDS  
MONROE COUNTY, MICH

1998 & 1999 G.B. Warnke Remonumentation Private Corner


I, George B. Warnke, Jr., in a field survey on 12/22/1998 & 8/39/99 do hereby state that under requirements of P.A. 74, Michigan P.A. of 1970, the corner points mentioned in lines 1 and 2 above were in conformance with regulations and rules therefore as required in the current manual of survey instructions of the United States Department of the Interior, Bureau of Land Management or by decree of a Court of Law and / or that the corner points mentioned in lines 3, 4 and 5 above were in conformance with the rules of the Michigan Board of Land Surveyors or by a Decree of a Court of Law; established, re-established, monumented, recovered, found as expressed below:

NOTE: Not more than 2 corners, all in the same town and range, may be recorded on this certificate.

A. Description of original monument and accessories and/or subsequent restoration:

- 1817 - GLO / Joseph Fletcher / West on the true line between Secs. No. 15 & 22 - 39.98 Set the 1/4 sec. post of average dis. from which a B. Ash 10 ins. dia. bears N35W 5 lks. dis. & a W. Ash 12 ins. dia. bears S6W 26 lks. dis.
- 1885 - Willis Baldwin / Notes / Stone
- 4/1960 - Raymond Graf / witness card / Boat Spike in line with fence to South Outside edge of S.E. wingwall of bridge S88°W 244.13 & Outside edge of N.E. wingwall N87°W 224.26 & N.E. corner of house S54°W 155.52
- 1961 - Detroit Edison / Drawings #5MS724-13, 5MS724-15 & SE724-28 / Fd 5/8" Sq. Rod
- 5/1967 - Detroit Edison / field notes / Fd. Sq. 3/4" Rod
- Date? - Angelo Marino / field notes / F.I. Pin
- 1976 - Angelo Marino / field notes / Boat spike / northeasterly 21.22' guard post & northwesterly 35.67' guard post & southeasterly 56.83' guard post westerly 375.14' centerline of I-75 bridge & southwesterly 75.22' guard post
- 6/1987 - Boyd Arthurs / Detroit Edison / Drawing #S.E. 724 51 / Bent Rod in Hand Hole Monument / Northerly 26.91' P.K. nail in W. face of 6"x8" wood guard rail post & Southerly 40.03' P.K. nail in W. face of 6"x8" wood guard rail post & Westerly 242.06' easterly side of conc. bridge deck for I-75
- 8/1988 - Arthur Crossman / Job #21640 / Square Rod in Monument Road Box
- 8/1988 - Gregory Stephens - Detroit Edison / Drawing #SE FREN-1 / Found 3/4" Sq. Bar in Mon. Box
- 9/1988 - Arthur Crossman / LCRC, Liber 3, Page 41 / Found and used square rod in road box. Verified for E-W distance by R/W fence west of expressway I-75 and by distance to line of irons on 1/8" line west of N1/4 corner / North 26.95' PK nail W side most Ely Guard rail post & N60W 77.75' PK nail E side 9th Guard rail post west S10W 40.17' PK nail W side most Ely Guard rail post & South 37.83' 1x1 wood stake
- 11/1988 - George B. Warnke, Jr. / Job #88-665 / Found Square Iron Rod in Monu. Box / West 375.14' CL I-75 R/W & North 27.06' nail & shiner in top of last wood guard rail post (rail to west) & S10°W 40.63' nail & shiner in top of last wood guard rail post
- 12/1992 - Gregory Stephens - Detroit Edison / Drawing #SE FRT-3 / Fd. 3/4" Sq. Bar in Mon. Box
- 1994 - George B. Warnke, Jr. / Survey #94-0089 / Square Rod in Monument Box / references LCRC, L3, P41 / North 26.95' PK nail W side most E'ly guard rail post & N60°W 77.75' PK nail E side 9<sup>th</sup> guard rail post west S10°W 40.17' PK nail W side most E'ly guard rail post & South 37.83' 1x1 wood stake
- 12/1996 - George B. Warnke, Jr. / Survey #96-0130 / Square Rod in Monument Box / references LCRC, L3, P41

Register of Deeds Stamp & File Number

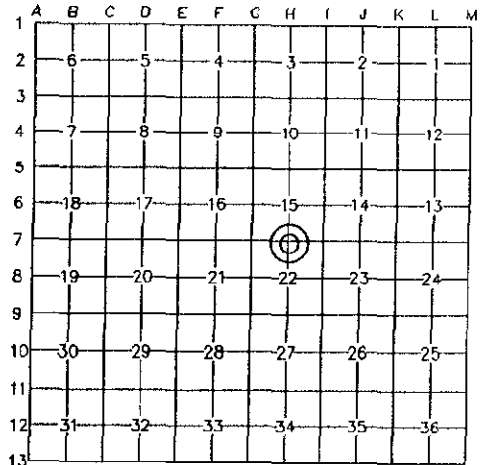


B. Description of corner evidence found and/or method applied in restoring or re-establishing corner:

- Corner is located in Nadeau road being east of I-75 in hard pavement.
- 12/1996 - found square rod in monument box & checked good with previous information.
- 8/30/99 - set plastic remonumentation cap on existing 3/4" hex rod in existing monument box with set 2" & 1-1/2" risers.
- 8/27/99 Fel bolt at surface 0.15 South & 0.05 East in part over buried mon. box
- RATIFIED BY PEER GROUP, PA 345 OF 1990, MONROE COUNTY, MICHIGAN, DATE 11/10/1998, COUNTY REP. *[Signature]*
- Corner is accepted as the best available evidence of the position of the original corner.

C. Description of monument for corner and accessories established to perpetuate locating the position of the corner:

- Set plastic remonumentation cap on existing rod in existing monument box with set 2" & 1-1/2" risers & Witnesses:
- South 10° West 40.62 feet to found nail & shiner to top most easterly guard rail post
- South 30° West 45.12 feet to nail & shiner in top 4<sup>th</sup> post to west
- South 45° West 56.50 feet to found PK nail in top 6<sup>th</sup> post to west - all are guard rail posts which were hit & repaired
- North 50° West 43.89 feet to found PK nail in top 6<sup>th</sup> post to west - area has a lot of traffic
- Northerly 28.37 feet to set nail & shiner top 3<sup>rd</sup> post to west

Signed by *[Signature]*  
Surveyor's Michigan License No. 19474

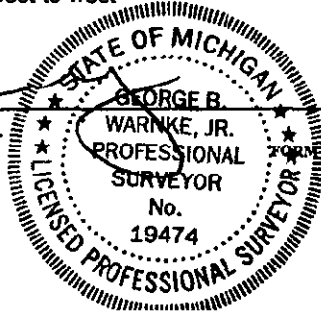

Date September 7, 1999

APPROVED BY MICHIGAN STATE BOARD OF LAND SURVEYORS, JAN. 28, 1971  
REVISED MAY 14, 1975  
REVISED JAN., 1983  
REVISED OCT., 1994