

SECTION

LAND CORNER RECORDATION CERTIFICATE
Filing Requirement of Act 74, Mich. P.A., 1970

For corners in MONROE (58)

- 1. Public Land Survey
2. Property Controlling in Section
3. Miscellaneous Property in Sec.
4. Lot No. Recorded Plat
5. Private Claims

Located In: FRENCHTOWN TWP.

Corner Code #

Table with columns T&S, R&E and rows for survey types 1-5.

RECEIVED FOR RECORD
99 OCT 14 AM 9:08
Hans Allen
REGISTER OF DEEDS
MONROE COUNTY, MICH

1998 & 1999 Remonumentation Program Corner

I, George B. Warnke, Jr., in a field survey on 1998 & 8/27/1999 do hereby state that under requirements of P.A. 74, Michigan P.A. of 1970, the corner points mentioned in lines 1 and 2 above were in conformance with regulations and rules therefore as required in the current manual of survey instructions of the United States Department of the Interior, Bureau of Land Management or by decree of a Court of Law and / or that the corner points mentioned in lines 3, 4

Register of Deeds Stamp & File Number

and 5 above were in conformance with the rules of the Michigan Board of Land Surveyors or by a Decree of a Court of Law; established, re-established, monumented, recovered, found as expressed below:
NOTE: Not more than 2 corners, all in the same town and range, may be recorded on this certificate.

A. Description of original monument and accessories and/or subsequent restoration:

GLO did not set center of section.

- 1903 - L. A. Howard - survey drawing / notes - set stone - witness: Elm 15 in.
1921 - J.W. White - survey drawing - material not noted - shows
1932 - O.A. Case - survey drawing - material not noted - shows N86°48'W 646.62' along
1939 - A.J. Marino - field notes - material not noted
1944 - F. Lankauf - survey drawing - stone - shows S88°10'E 384.78' along E&W 1/4
1950 - A.J. Marino - survey drawing & field notes - found old cor. post -
1951 - A.J. Marino - survey drawing - material not noted - shows N86°48'W 646.62' to very
1956 - Case & Fleck - copied survey drawing - material not noted - shows 384.78' to Nadeau Road
1967 - A.J. Marino - survey drawing - material not noted - shows due south 235.57' along fence line to creek
1972 - Case & Fleck - survey drawing #16420 - recorded in Liber 627, Page 549 - Iron Set - witnesses:
1973 - James Fraus - LCRC, Liber 1, Page 317 - Found "T" iron - witnesses:
1974 - G.B. Warnke - survey drawings #74-16 & 74-17 - Fd. "T" bar #6193 - witnesses (all compare closely to 1972 Case & Fleck):
1988 - G.B. Warnke - survey drawing #88-367 - found stone - witnesses: (found iron rod 0.3'S & 0.2'W.)
1990 - G.B. Warnke - LCRC, Liber 3, Page 115 - found broken stone - witnesses:
Year? - Detroit Edison - witness card - stone in fence lines (shows fence to east & west)
Year? - G.B. Warnke files - witness card - found "T" bar #6193 Fleck - witnesses:

Grid table with columns A-L and rows 1-13. Cell (8, I) contains '23' circled.

B. Description of corner evidence found and/or method applied in restoring or re-establishing corner:


Corner is not in road. It is +/- 385' westerly of Nadeau Road.
8/27/99 - Found 3/8" rod at south edge of granite stone about 10" x 10" x 15" tall. Found 2 witness spikes west & north. Dug around stone & pried to west. Set 1" x 36" iron pipe with set brass remonumentation cap at corner. Drove old steel fence post to northeast. Set remonumentation carsonite post 1/2 foot to south. Left 3/8" rod intact to south.

RATIFIED BY PEER GROUP, PA 345 OF 1990, MONROE COUNTY, MICHIGAN, DATE 12/8/1998, COUNTY REP.
This position was not established by original government surveyors. This monument is accepted as the best available evidence of the position of the corner.

C. Description of monument for corner and accessories established to perpetuate locating the position of the corner:

- Set 1" x 36" pipe with brass remonumentation cap & Witnesses:
North 80° West 9.5 feet to double head nail & brass remonumentation shiner in southerly face of 5" tree
North 10° West 5.65 feet to double head nail & brass remonumentation shiner in westerly face of 4" tree
20 foot brush row south & west
South 10° West 42.88 feet to nail in east face of 12" tree stump
North 85° West 47.18 feet to nail & shiner in south face of 18" thorn tree

Signed by [Signature]
Surveyor's Michigan License No. 19474

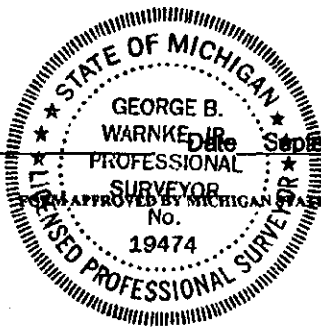

APPROVED BY MICHIGAN STATE BOARD OF LAND SURVEYORS, JAN. 28, 1971
REVISED MAY 14, 1975
REVISED JAN., 1983
REVISED OCT., 1994