

MAR 09 2000

SECTION

LAND CORNER RECORDATION CERTIFICATE
Filing Requirement of Act 74, Mich. P.A., 1970

For corners in

Form with fields for MONROE (58) County, Located In: FRENCHTOWN TWP., Corner Code # K-6, and numbered items 1-5 describing the survey type and lot details.

RECEIVED FOR RECORD
99 AUG -2 AM 10:41
REGISTER OF DEEDS
MONROE COUNTY, MICH

Register of Deeds Stamp & File Number


1998 & 1999 G.B. Warnke Private Remonumentation Corner

I, George B. Warnke, Jr., in a field survey on Aug. - Dec., 1998 do hereby state that under requirements of P.A. 74, Michigan P.A. of 1970, the corner points mentioned in lines 1 and 2 above were in conformance with regulations and rules therefore as required in the current manual of survey instructions of the United States Department of the Interior, Bureau of Land Management or by decree of a Court of Law and / or that the corner points mentioned in lines 3, 4 and 5 above were in conformance with the rules of the Michigan Board of Land Surveyors or by a Decree of a Court of Law; established, re-established, monumented, recovered, found as expressed below:

NOTE: Not more than 2 corners, all in the same town and range, may be recorded on this certificate.

A. Description of original monument and accessories and/or subsequent restoration:

- List of survey records including dates, names (e.g., Joseph Fletcher, A.J. Marino, Glenn Richard, G.B. Warnke), descriptions of monuments (e.g., sugar posts, spikes, iron pipes), bearings, distances, and references to previous surveys.

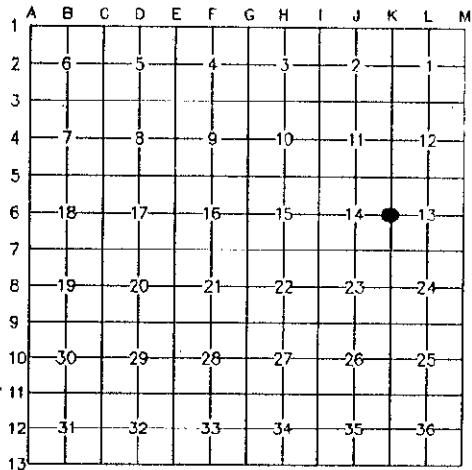

B. Description of corner evidence found and/or method applied in restoring or re-establishing corner:

Corner located on Newport South Road (1/2 mile south of Post Road) in 3" asphalt over 8" concrete (bad condition) over clay. 1998 - found concrete nail at surface at 18.75 feet north of gauge of north rail. Used 18.29 feet to gauge & dug hole & found old PK nail in asphalt. Concrete pavement below was deteriorated too much to determine the location of "+" referenced by A.J. Marino in 1937. Set 1" x 36" pipe with brass remonumentation cap in monument box with glass & metal pieces around pipe about 30" deep. Checked good on Glen Richard's witnesses.

RATIFIED BY PEER GROUP, PA 345 OF 1990, MONROE COUNTY, MICHIGAN, DATE 9/29/1998, COUNTY REP. REMONUMENTATION: Set 1" x 36" pipe with brass remonumentation cap in monument box to replace old PK nail and is accepted as the best available evidence of the position of the original corner.

C. Description of monument for corner and accessories established to perpetuate locating the position of the corner:

Set 1" x 36" pipe with brass remonumentation cap in monument box & Witnesses: East & West 33 feet to found 1" pipes, South 18.29 feet to gauge of north rail, South 85° West 17.83 feet to set nail w/ remon. tag in east face of RR crossing sign post, South 30° East 41.34 feet to set nail w/ remon. tag in west face of RR crossing sign post, South 12° East 148.40 feet to set nail w/ remon. tag on west face of electric pole



Signed by [Signature] Surveyor's Michigan License No. 19474

Date May 13, 1999