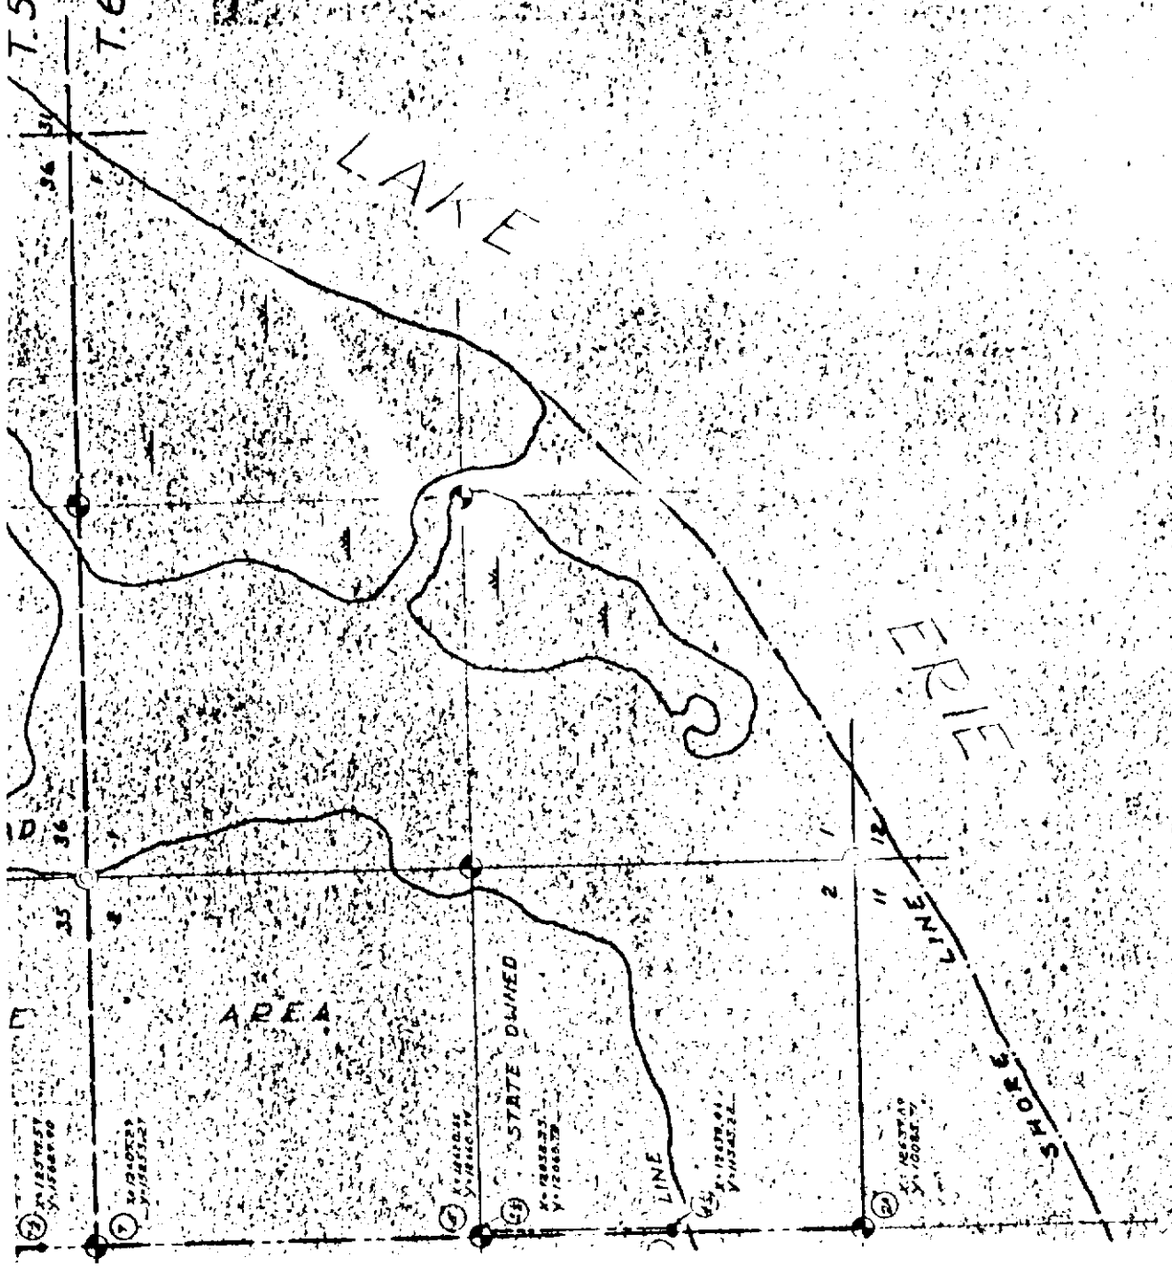NOTE: This survey was based on the assumption that the section and quarter-section corners, which were found in place, were perpetuated from the United States Land Survey of 1817. Lost corners were established by proportional measurements from the known corners. Fence lines and marked boundaries long acquiesced were recognized as property lines. The following survey points (1), (2), (4), (6), (5), (12), (7), (11), (8), (9), (13), (14), (15), (16), (17), (18), (19), (20), (21), (22) and (23) delineate the property line and are monumented with 1" thick iron pipe, filled with concrete and capped with a standard Michigan section corner brass cap on which the location data is stamped.