

that the section and  
acc. were perpetuated  
at corners were estab.  
own corners. Fence  
is recognized as property

(15), (16), (17), (18),  
(19), (20), (21), (22), (23)


and are monumented with  
of with a standard  
location data is stamped.

#### WITNESSES

- (15) 1/4 Corner 26, 27, 34, 35  
1" Iron Pipe Bl. centerline Roberts & Isho Riv.  
S. 67° 15' W., 49.18 ft. to noise spike in 24" silver maple  
E. 97° 30' E., 35.29 ft. to 2" pipe road sign  
N. 69° 45' W., 19.66 ft. to steel I fence post 8 in. high  
E. 28° 30' E., 44.35 ft. to center of 10 in. box alder tree
- (16) 1/4 Corner bet. 34 & 35  
Bl. 6 in. gray rock, trace of broken glass  
Set brass S. C. Mon. on 1 in. iron pipe, 4 in. below rd. surface  
N. 41° W., 34.34 ft. to 2" pipe road sign  
E. 49° E., 25.73 ft. to a H. gate post, 1" iron pipe  
N. 82° 30' E., 20.30 ft. to a S. gate post, 3" iron pipe
- (17) 1/4 Corner 2, 3, 34, 35  
Bl. old square wood stake in rotted condition  
Set brass S. C. Mon. on 1" iron pipe, 5 in. below rd. surface  
S. 85° 30' E., 20.31 ft. to a horiz. spike in 1 1/2 in. elm  
E. 50° 30' W., 34.46 ft. to 2 in. pipe road sign  
N. 68° W., 83.13 ft. to horiz. spike in S. W. side 30 in. elm  
Set on centerline Robert Riv., 110.3 ft. to E. edge conc. bridge deck
- (18) 1/4 corner bet. 2 & 3  
Bl. 5/8 d. spike 12" west of Bl. centerline 7 in line with fence west.  
Used by local surveyors for property surveys  
Set 3/4" x 30" iron pipe & wood stk. marker  
N. 49° E., 34.92 ft. to steel T fence post  
N. 42° 30' W., 14.71 ft. to horiz. spike in 7 in. fence post  
N. 56° 45' E., 87.67 ft. to S. W. cor. of house foundation
- (19) 1/4 corner bet. 34 & 35  
Bl. 6 in. x 12 in. rock, N. wheel track, Reserve Rd.  
Fence lines north & south. information via local residents.  
Set brass S. C. Mon. on 1 in. pipe 6" below rd. surface  
N. 18° W., 29.39 ft. to a horiz. spike in 1 1/2 in. elm  
E. 78° 15' W., 108.85 ft. to a horiz. spike in 6" tel. pole  
S. 78° E., 108.68 ft. to a horiz. spike in 6" tel. pole  
N. 13° W., 19.39 ft. to a horiz. spike in 8" fence post

#### LEGEND

MARSH  
IRON PIPE  
STATE BOUNDARY  
COUNTY LINE  
SECTION LINE  
TOWNSHIP LINE  
QUARTER COR.  
SECTION COR.  
TOWNSHIP COR.  
PAVED RD.  
GRAVEL RD.  
DIRT RD.  
PRIVATE CLAIM  
BRIDGE  
SURVEY POINT LOCATION

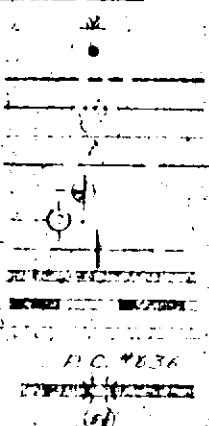

This is to certify that in January 1956, I made a survey  
of the tract delineated hereon and that it is drawn in accord-  
ance with field notes of said survey.

W.L. PARRISON

