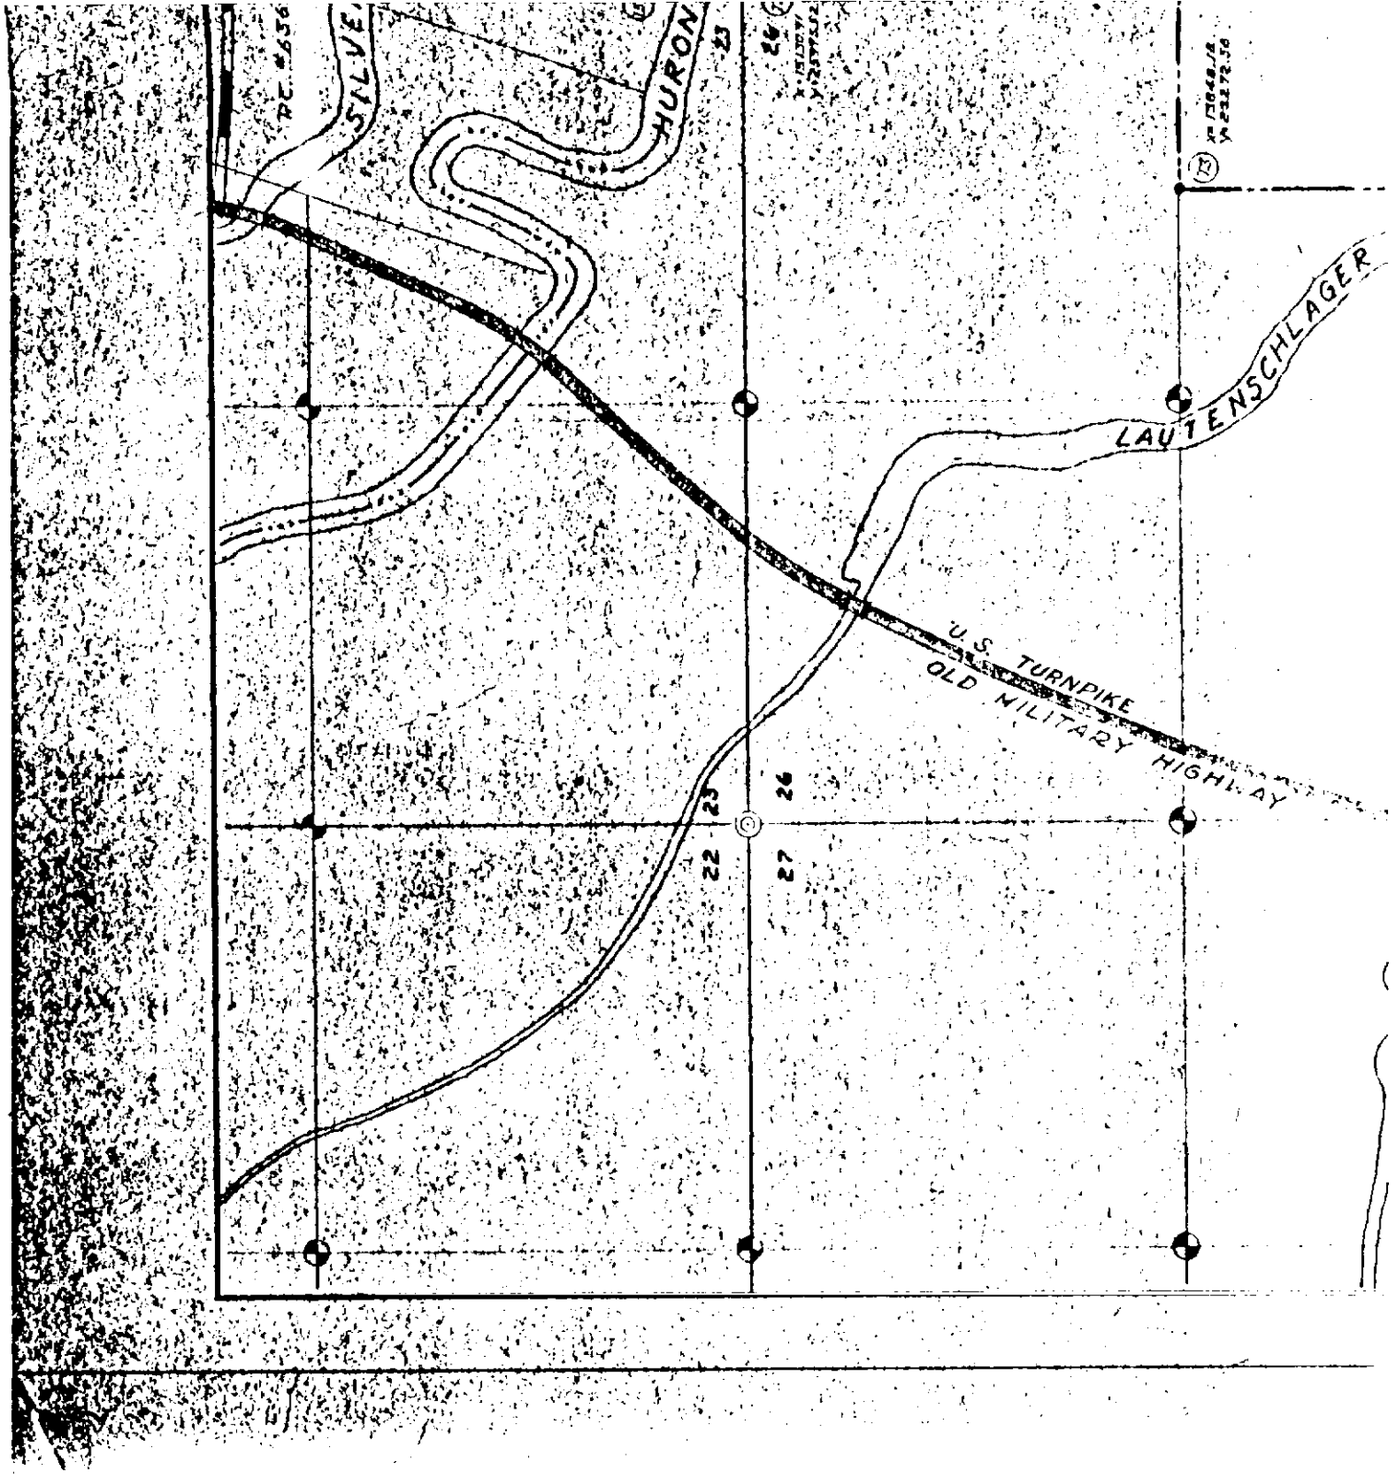
HURON
LAUTENSCHLAGER
U.S. TURNPIKE
OLD MILITARY HIGHWAY
22
23
24
26
27