


PAVED RD.
GRAVEL RD.
DIRT RD.
PRIVATE CLAIM
BRIDGE
SURVEY POINT LOCATION

REGISTERED CIVIL ENGINEER &
LAND SURVEYOR
P.C. #836
(5)

This is to certify that in January 1956, I made a survey of the tract delineated hereon and that it is drawn in accordance with field notes of said survey.

W.L. PADDISON

REGISTERED CIVIL ENGINEER &
LAND SURVEYOR: #7256

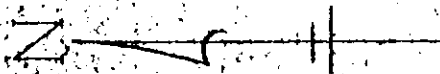

SCALE 1" = 800'

MICHIGAN DEPARTMENT OF CONSERVATION ENGINEERING AND ARCHITECTURE ADMINISTRATIVE SERVICES		
POINTE MOUILLEE BOUNDARY SURVEY MONUMENT DETAILS		
GAME DIVISION WAYNE-MONROE COUNTY		
APPROVED	<i>Hollaway J. Hanson</i> 6-5-58 ENGINEER IN CHARGE DATE	PLAN E 82A-17
APPROVED	_____ CHIEF OF SPONSORING DIVISION DATE	SHEET 2 OF 2
APPROVED	_____ REG. PROF. ENGINEER OR ARCHITECT DATE	REVISED
SURVEYED BY	W.L. PADDISON 1-56	AMM 7/14/56
DESIGNED BY	A.K.M. CANN E.L. SIGGRIDE 3-58	
CHECKED BY	W.L. PADDISON 5-58 NAME DATE	INITIAL DATE

E 82A-17