

**SURVEY &
REMONUMENTATION**

NOV 10 1997

COMMISSION

**LAND CORNER RECORDATION CERTIFICATE
Filing Requirement of Act 74, Mich. P.A., 1970**

RECEIVED FOR RECORD

97 SEP 24 PM 3:24

Terri Allen
REGISTER OF DEEDS
MONROE COUNTY, MICH

For corners in

<u>Monroe</u> (County)	Located In:	Corner Code #
	Summerfield Twp.	
1. Public Land Survey	T <u>7S</u> R <u>6E</u>	<u>F-6</u>
	T _____ R _____	_____
	T _____ R _____	_____
	T _____ R _____	_____
2. Property Controlling in Section	S _____ T _____ R _____	_____
	S _____ T _____ R _____	_____
3. Miscellaneous Property in Sec.	S _____ T _____ R _____	_____
	S _____ T _____ R _____	_____

Register of Deeds Stamp & File Number


4. Lot No. _____, Recorded Plat _____

5. Private Claims _____

I, George B. Warnke, Jr., in a field survey on 19 97 do hereby state that under requirements of P.A. 74, Michigan P.A. of 1970, the corner points mentioned in lines 1 and 2 above were in conformance with regulations and rules therefore as required in the current manual of survey instructions of the United States Department of the Interior, Bureau of Land Management or by decree of a Court of Law and / or that the corner points mentioned in lines 3, 4 and 5 above were in conformance with the rules of the Michigan Board of Land Surveyors or by a Decree of a Court of Law; established, re-established, monumented, recovered, found as expressed below:

NOTE: Not more than 2 corners, all in the same town and range, may be recorded on this certificate.

CENTER SECTION OF SECTION 16 (STULL ROAD 1/2 MILE NORTH IDA-CENTER)
1997 G.B. Warnke Corner

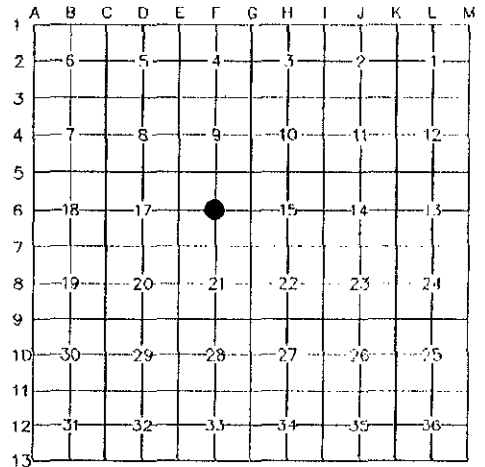

A. Description of original monument and accessories and/or subsequent restoration:

F-6, T7S, R6E

- 1898, L.A. Howard found stone.
- 1973, Warnke survey recorded in Liber 643, Page 458, found railroad spike and replaced with 5/8 inch pin.
- 1977, Warnke survey recorded in Liber 736, Page 505, found pin and Warnke LCRC recorded in Liber 2, Page 216, found pin.
- 1993, Warnke survey (File No. 93-0055), found 5/8 inch pin.

B. Description of corner evidence found and/or method applied in restoring or re-establishing corner:

June, 1996, Warnke survey recorded in Liber 1526, Page 0340, found 5/8 inch pin at surface.
8/12/97 corner was ratified by peer group PA 345 of 1990 Monroe County, Michigan *[Signature]*

C. Description of monument for corner and accessories established to perpetuate locating the position of the corner:

F-6 On 8/22/97 set 1" x 36" pipe with brass remonumentation cap replacing found 5/8 inch pin. This position was not established by original government surveyors. This monument is accepted as the best available evidence of the position of the corner.

Witnesses:

- North 50° West 40.58 feet to found nail and shiner in southwest face electric pole
- North 38° West 94.34 feet to found nail and shiner in south face telephone pole
- South 73° West 40.28 feet to found nail and shiner in north face telephone pole
- South 10° East 83.93 feet to set nail and shiner in west face ATT wood post (#227)

Signed by *[Signature]*
Surveyor's Michigan License No. 19474



8-27-96