

**SURVEY &  
REMONUMENTATION**

DEC 1 8 1996

**COMMISSION LAND CORNER RECORDATION CERTIFICATE**  
Filing Requirement of Act 74, Mich. P.A. 1970

RECEIVED FOR RECORD  
96 SEP -6 PM 1:53

For corners in

<u>MONROE</u> <small>(County)</small>	Located In:	Corner Code <del>##</del>
1. Public Land Survey SUMMERFIELD TWP.	T _____ R _____ T <del>7S</del> R <del>6E</del> T _____ R _____ T _____ R _____	_____ J-13 _____ _____ _____
2. Property Controlling in Section	S _____ T _____ R _____ S _____ T _____ R _____	_____ _____
3. Miscellaneous Property in Sec.	S _____ T _____ R _____ S _____ T _____ R _____	_____ _____

*Jan Allen*  
REGISTER OF DEEDS  
MONROE COUNTY, MICH

Register of Deeds Stamp & File Number

4. Lot No. \_\_\_\_\_, Recorded Plat \_\_\_\_\_  
5. Private Claims \_\_\_\_\_

Corner Submitted by George B. Warnke

I, G.B. WARNKE, JR., in a field survey on 1995 & 1996, 19 \_\_\_\_\_, do hereby certify that under requirements of P.A. 74, Michigan P.A. of 1970, the corner points mentioned in lines 1 and 2 above were in conformance with regulations and rules therefore as required in the current manual of survey instructions of the United States Department of the Interior, Bureau of Land Management or by a decree of a Court of Law and/or that the corner points mentioned in lines 3, 4 and 5 above were in conformance with the rules of the Michigan Board of Land Surveyors or by a Decree of a Court of Law; established, re-established, monumented, re-monumented, recovered, found as expressed below:

**NOTE: Not more than 4 corners, all in the same town and range, may be recorded on this certificate.**

A	B	C	D	E	F	G	H	I	J	K	L	M
2	6	5	4	3	2	1						
3												
4	7	8	9	10	11	12						
5												
6	18	17	16	15	14	13						
7												
8	19	20	21	22	23	24						
9												
10	30	29	28	27	26	25						
11												
12	31	32	33	34	35	36						
13												

A. Description of original monument and accessories and/or subsequent restoration:

1/4 Corner Common To Section 35 on south twp. line at Rauch & Covert Roads being in tarby 1819, GLO Surveyor, Joseph Fletcher, set 1/4 Section post and witnessed: W. Oak 12 inch North 62° West 30 links & W. Oak 30 inch North 13° East 39 links.  
1900, L.A. Howard found stone.  
1903, L.A. Howard found stone, notes checked to stumps of original witness trees.  
1904, L.A. Howard notes stone found.  
1909, L.A. Howard found stone.  
1973, Case & Fleck recorded survey (Liber 650, Page 468) notes found stone & set I.P.

RATIFIED BY PEER GROUP  
PA 345 OF 1990  
MONROE COUNTY, MICHIGAN  
date: 2/27/1996  
County Rep.: [Signature]

B. Description of corner evidence found and/or method applied in restoring or reestablishing corner:


April 1995, G.B. Warnke crew found 1 inch iron pipe being 1 inch below pavement in a 2 inch square hole. Witness to house corner and to Oak tree per Case & Fleck recorded survey checked.  
8/21/1996, G.B. Warnke and crew found 1/2" x 18-20" iron pipe with flattened top. Dug 20" diameter hole and found 10-13" diameter granite at 1.9 feet. Found 5" long, 1" x 3" stake in north edge of hole at 2 foot depth. There were previous signs of excavation. Found red Keil mark on granite under found pipe. Lifted out stone with no sign of a post. Set 1" x 36" iron pipe with brass remonumentation cap; back filled and laid found 1/2" iron pipe NE - SW at 15" depth next to new iron and set monument box.

C. Description of monument for corner and accessories established to perpetuate locating the position of the corner:

Set 1" x 36" iron pipe with brass remonumentation cap in monument box to replace found iron pipe and is accepted as the best available evidence of the position for corner and witnesses:  
South 45° East 144.69 feet to northwest corner of foundation to house No. 5501  
South 61° East 102.40 feet to found new PK nail in northerly face of 24 inch Oak  
North 58° East 55.09 feet to set nail and tag in north face of telephone pole  
South 30° East 42.45 feet to set nail and tag in north face of telephone pole  
East 91.54 feet to found 3/4 inch rebar at north 1/4 corner of Section 2, T8S, R6E (J-1)

Signed by [Signature] Date Aug 127/1996

Surveyor's Michigan License No. 19474

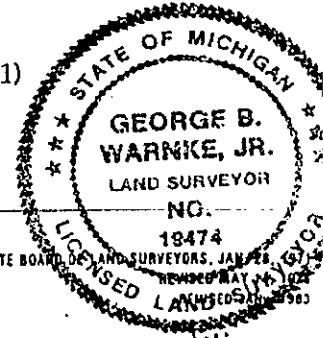

FORM APPROVED BY MICHIGAN STATE BOARD OF LAND SURVEYORS, JAN 28, 1974

George B. Warnke Corner / Ref.95-0036