

LAND CORNER RECORDATION CERTIFICATE
Filing Requirement of Act 74, Mich. P.A. 1970

RECEIVED FOR RECORD
 95 SEP -6 PH 1:47

For corners in

MONROE

(County)

Located In:

Corner Code #

1. Public Land Survey	T	R	
SUMMERFIELD TWP.	T 7S	R 6E	K-11
	T	R	
	T	R	
2. Property Controlling	S	T	R
in Section	S	T	R
3. Miscellaneous	S	T	R
Property in Sec.	S	T	R

George B. Warnke
 REGISTER OF DEEDS
 MONROE COUNTY, MICH

Register of Deeds Stamp & File Number

4. Lot No. _____, Recorded Plat _____
 5. Private Claims _____

G.B. Warnke Corner

I, G.B. WARNKE, JR., in a field survey on 11/28/1995 & 1996, 19_____, do hereby certify that under requirements of P.A. 74, Michigan P.A. of 1970, the corner points mentioned in lines 1 and 2 above were in conformance with regulations and rules therefore as required in the current manual of survey instructions of the United States Department of the Interior, Bureau of Land Management or by a decree of a Court of Law and/or that the corner points mentioned in lines 3, 4 and 5 above were in conformance with the rules of the Michigan Board of Land Surveyors or by a Decree of a Court of Law, established, re-established, monumented, re-monumented, recovered, found as expressed below:

A	B	C	D	E	F	G	H	I	J	K	L
2	6	5	4	3	2						
3											
4	7	8	9	10	11						
5											
6	18	17	16	15	14						
7											
8	19	20	21	22	23	24					
9											
10	30	29	28	27	26	25					
11											
12	31	32	33	34	35	36					
13											

NOTE: Not more than 4 corners, all in the same town and range, may be recorded on this certificate.

A. Description of original monument and accessories and/or subsequent restoration:

Section corner common to Sections 25, 26, 35 & 36 on Morocco Rd in gravel (West of Summerfield Road) 1819, GLO Surveyor Joseph Fletcher set post corner of Section 25, 26, 35 & 36 and witnessed:
 Elm 12" N86° W, 26 lks & Elm 7" N20° E, 4 lks;
 1900, 1903, & 1904, L.A. Howard found stone;
 1972, G.M. Barton field notes notes found iron pin;
 1973, L.C.R.C. (Liber 1, Pages 369 & 370) found old 1" iron pipe (1/2" iron pipe 8.40 feet north);
 1985, G.B. Warnke survey No. 85-409 notes found iron pipe;
 1990, J.C. Andrus survey No. 90S-5897 notes found existing iron pipe;
 1993, J.C. Andrus survey No. 93S-6908 notes found pipe.

B. Description of corner evidence found and/or method applied in restoring or reestablishing corner:

1995, G.B. Warnke field crew found a 1 1/4" OD iron pipe 6" below gravel roadway. Dig 2 foot diameter hole being 2' deep and probed, found nothing else. From remains of the witnesses of the 1973 L.C.R.C., it was determined that this was the same iron pipe called out.
 2/27/1996, Corner approved by Remonumentation Peer Group (review dossier for further information)
 8/1/1996, G.B. Warnke crew set 1" x 36" iron pipe with brass remonumentation cap to replace found point and witnesses as shown below.

REMONUMENTATION

DEC 1 6 1996

COMMISSION


RATIFIED BY PEER GROUP
 PA 345 OF 1990
 MONROE COUNTY, MICHIGAN
 date: 2/27/1996
 County Rep.: *[Signature]*

C. Description of monument for corner and accessories established to perpetuate locating the position of the corner:

Set 1" x 36" iron pipe with brass remonumentation cap to replace found 1 1/4" O.D. iron pipe and is accepted as the best available evidence of the position of the original corner and witnessed:
 South 50° East 165.95 feet to northeast corner of foundation of house No. 15939
 South 70° East 87.15 feet to found PK nail in northeast face of 30" Maple tree
 North 04° West 8.50 feet to found 5/8" iron rod
 North 13° East 18.55 feet to southeast corner of easterly edge of old concrete railroad bridge headwall
 North 29° West 15.65 feet to southwest corner of angle point of old concrete railroad bridge headwall
 South 27° East +/- 32 feet to stump of 14" Cherry
 North 45° East +/- 25 feet to 9" stump at toe of slope

Signed by *[Signature]*
 Surveyor's Michigan License No. 19474

Date 8/22/1996

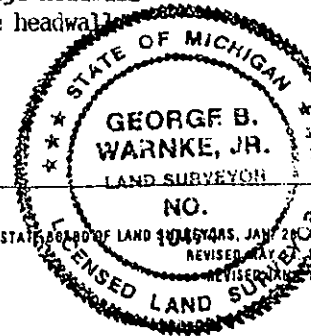

FORM APPROVED BY MICHIGAN STATE BOARD OF LAND SURVEYORS, JAN 28, 1993, REVISED MAY 19, 1993

G.B. Warnke Corner / 95-0036 & 95-0148