

DEC 1 6 1996

**COMMISSION**

**LAND CORNER RECORDATION CERTIFICATE  
Filing Requirement of Act 74, Mich. P.A. 1970**

RECEIVED FOR RECORD  
95 SEP -6 PM 1:50

For corners in  
Monroe

(County)

Located In:

Corner Code ##

1. Public Land Survey	T	R	
Summerfield Twp.	T	7SR	6E
	T	R	
	T	R	
2. Property Controlling	S	T	R
in Section	S	T	R
3. Miscellaneous	S	T	R
Property in Sec.	S	T	R

1-11

*Janice Allen*  
REGISTER OF DEEDS  
MONROE COUNTY, MICH.

Register of Deeds Stamp & File Number

4. Lot No. \_\_\_\_\_, Recorded Plat \_\_\_\_\_  
5. Private Claims \_\_\_\_\_

A	B	C	D	E	F	G	H	I	J	K	L
2	6	5	4	3	2						
3											
4	7	8	9	10	11						
5											
6	18	17	16	15	14						
7											
8	19	20	21	22	23	24					
9											
10	30	29	28	27	26	25					
11											
12	31	32	33	34	35	36					
13											

**George B. Warnke Corner**

I, G.B. WARNKE, JR., in a field survey on 5/26/1995 & 1996, 19\_\_\_\_ do hereby certify that under requirements of P.A. 74, Michigan P.A. of 1970, the corner points mentioned in lines 1 and 2 above were in conformance with regulations and rules therefore as required in the current manual of survey instructions of the United States Department of the Interior, Bureau of Land Management or by a decree of a Court of Law and/or that the corner points mentioned in lines 3, 4 and 5 above were in conformance with the rules of the Michigan Board of Land Surveyors or by a Decree of a Court of Law; established, re-established, monumented, re-monumented, recovered, found as expressed below:

**NOTE: Not more than 4 corners, all in the same town and range, may be recorded on this certificate.**

**A. Description of original monument and accessories and/or subsequent restoration:**

1/4 Section Corner common to Sections 25 & 36 / On Morocco Road in gravel. (East of Summerfield Road)  
1819, GLO Surveyor Joseph Fletcher set 1/4 Section post - no witnesses.  
April 1900, L.A. Howard notes stone found.  
October 1904, L.A. Howard notes stone.  
September 1954 to August 1955 field notes by Raymond Graf, for relocation of U.S.23, found limestone.  
June 1990, J.C. Andrus (survey #90s-5897) notes found existing iron.  
June 1993, J.C. Andrus (survey #93S-6908) notes found iron pipe.

**B. Description of corner evidence found and/or method applied in restoring or reestablishing corner:**

April 19, 1995, G.B. Warnke crew excavated corner, found bent 1/2 inch pipe 2 inches below gravel, removed iron and at a depth of 18 inches below gravel found 8 inch long x 6 inch wide stone. Bent iron pipe was over high point of stone (high point is 0.25 feet north of south end of stone) set 1 inch iron pipe 0.3 feet south of high point (iron was driven 3 inches below top of stone) set railroad spike 4 inches below gravel surface over high point of stone.  
2/27/1996, corner was Approved by Remonumentation Peer Group (see dossier for further information.)  
8/1/1996, G.B. Warnke crew set 1" x 36" iron pipe with brass remonumentation cap and broke found stone and placed pieces of stone and railroad spike around iron to replace stone.  
*No evidence of post found*


**C. Description of monument for corner and accessories established to perpetuate locating the position of the corner:**

Set 1" x 36" iron pipe with brass remonumentation cap and broke found stone and placed pieces of stone and railroad spike around iron to replace found stone and is accepted as the best evidence of the position of the original corner and witnesses:

- North 18.29 feet to found nail/shiner in south face of 7 inch Box Elder
- North 25° East 26.75 feet to found nail/shiner in south face of 11 inch Box Elder
- South 70° East 69.31 feet to found PK nail in southerly face of telephone pole
- South 32.00 feet to found nail/shiner in east face of 4 inch diameter wood post.

RATIFIED BY PEER GROUP  
PA 345 OF 1990  
MONROE COUNTY, MICHIGAN  
date: 2/27/96  
County Rep.: *[Signature]*

Signed by *[Signature]*  
Surveyor's Michigan License No. 19474  
George B. Warnke Corner / Ref. 95-0036 & 95-0148

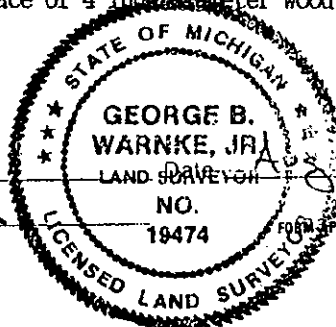

22, /1996

FORM APPROVED BY MICHIGAN STATE BOARD OF LAND SURVEYORS, JAN. 28, 1988  
REVISED MAY 14, 1990  
REVISED JAN., 1991