

MAY 2 1997

LAND CORNER RECORDATION CERTIFICATE
Filing Requirement of Act 74, Mich. P.A. 1970

97 JUN 10 PM 2:04

For corners in

MONROE

(County)

Located In:

Corner Code #

- 1. Public Land Survey
SUMMERFIELD TOWNSHIP
T _____ R _____
T 7S R 6E I-12
T _____ R _____
T _____ R _____
- 2. Property Controlling
in Section
S _____ T _____ R _____
S _____ T _____ R _____
- 3. Miscellaneous
Property in Sec.
S _____ T _____ R _____
S _____ T _____ R _____

Paul Allison
REGISTER OF DEEDS
MONROE COUNTY, MICH

Register of Deeds Stamp & File Number

- 4. Lot No. _____, Recorded Plat _____
- 5. Private Claims _____

George B. Warnke Corner

I, G. B. WARNKE, JR., in a field survey on 1995 & 1996, 19 _____, do hereby certify that under requirements of P.A. 74, Michigan P.A. of 1970, the corner points mentioned in lines 1 and 2 above were in conformance with regulations and rules therefore as required in the current manual of survey instructions of the United States Department of the Interior, Bureau of Land Management or by a decree of a Court of Law and/or that the corner points mentioned in lines 3, 4 and 5 above were in conformance with the rules of the Michigan Board of Land Surveyors or by a Decree of a Court of Law; established, re-established, monumented, re-monumented, recovered, found as expressed below:

NOTE: Not more than 4 corners, all in the same town and range, may be recorded on this certificate.

A	B	C	D	E	F	G	H	I	J	K	L
2	8	5	4	3	2						
3											
4	7	8	9	10	11	12					
5											
6	18	17	16	15	14	13					
7											
8	19	20	21	22	23	24					
9											
10	30	29	28	27	26	25					
11											
12	31	32	33	34	35	36					
13											

A. Description of original monument and accessories and/or subsequent restoration:

Center of Section 36 / Located in grassy area north of Cortz Road.
Not set by GLO. Established by private surveyor.
1893, B.M. Wilcox set stone where 1/4 lines cross.
1954 - 1955, Raymond Graf found 3/4 inch iron pin 12 inches deep, per M.S.H.D. field notes.

B. Description of corner evidence found and/or method applied in restoring or reestablishing corner:

5/26/1995, found 3/4 inch iron pin 1 foot deep with mushroom top, based on said M.S.H.D. field notes.
8/1/1996, set 1" x 36" iron pipe with brass remonumentation cap to replace found pin and witnesses are as shown below.

C. Description of monument for corner and accessories established to perpetuate locating the position of the corner:

Set 1" x 36" iron pipe with brass remonumentation cap to replace found 3/4 inch iron pin with mushroom top being 1 foot deep. This position not established by original government surveyors. This monument is accepted as the best available evidence of the position of the corner. Witnesses:
North 30° West 28.04 feet to set nail/shiner in southeast face of 10 inch Maple
North 65° West 62.50 feet to set nail/shiner in southeast face of 9 inch Maple
North 50° East 35.19 feet to set nail/shiner in southwest face of 10 inch Poplar
South 40° West 15.04 feet to set nail/shiner in northeast face of 12 inch Maple
West 88 1/2 feet to centerline of pavement of Summerfield Road

RATIFIED BY PEER GROUP
PA 345 OF 1990
MONROE COUNTY, MICHIGAN
date: 2/27/97
County Rep.: [Signature]


Signed by

[Signature]

Date

/1996

Surveyor's Michigan License No.

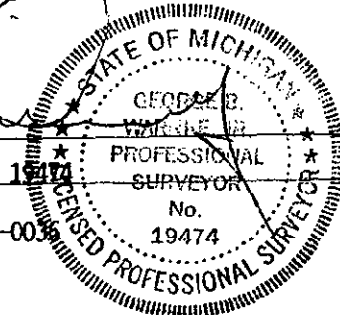

G.B. Warnke Corner / 94-0076/95-0036