

**SURVEY &
REMONUMENTATION**

DEC 1 6 1996

COMMISSION

LAND CORNER RECORDATION CERTIFICATE
Filing Requirement of Act 74, Mich. P.A. 1970

RECEIVED FOR RECORD
96 SEP -6 PM 1:52

For corners in

<u>MONROE</u> <small>(County)</small>	Located In:	Corner Code ##
1. Public Land Survey SUMMERFIELD TWP.	T ___ R ___ T <u>7S</u> R <u>6E</u> T ___ R ___ T ___ R ___	_____ <u>L-13</u> _____ _____
2. Property Controlling in Section	S ___ T ___ R ___ S ___ T ___ R ___	_____ _____
3. Miscellaneous Property in Sec.	S ___ T ___ R ___ S ___ T ___ R ___	_____ _____

Eric Allen
REGISTER OF DEEDS
MONROE COUNTY, MICH

Register of Deeds Stamp & File Number

4. Lot No. _____, Recorded Plat _____
5. Private Claims _____

A	B	C	D	E	F	G	H	I	J	K
2	6	5	4	3	2					
3										
4	7	8	9	10	11					
5										
6	18	17	16	15	14					
7										
8	19	20	21	22	23					
9										
10	30	29	28	27	26					
11										
12	31	32	33	34	35					
13										

George B. Warnke Corner

I, G.B. WARNKE, JR., in a field survey on 1995 & 1996, 19 _____, do hereby certify that under requirements of P.A. 74, Michigan P.A. of 1970, the corner points mentioned in lines 1 and 2 above were in conformance with regulations and rules therefore as required in the current manual of survey instructions of the United States Department of the Interior, Bureau of Land Management or by a decree of a Court of Law and/or that the corner points mentioned in lines 3, 4 and 5 above were in conformance with the rules of the Michigan Board of Land Surveyors or by a Decree of a Court of Law; established, re-established, monumented, re-monumented, recovered, found as expressed below:

NOTE: Not more than 4 corners, all in the same town and range, may be recorded on this certificate.

A. Description of original monument and accessories and/or subsequent restoration:

1/4 Corner on south line of township & Section 36 on centerline of Rauch Road being tarby pavement, 1819, GLO Surveyor Joseph Fletcher set 1/4 Section post and witnessed: W. Oak 20 S70E 72 lks. December 1893, B.M. Wilcox establish corner 1/2 distance between Section corners.
April 1900, L.A. Howard set stone.
October & November 1904, L.A. Howard notes stone.
July 1993, J.C. Andrus survey (#93S-6908) set railroad spike equal distance between existing Section corners K-13 & M-13.
June 1994, G.B. Warnke survey (#94-0076-2) found railroad spike.

B. Description of corner evidence found and/or method applied in restoring or reestablishing corner:


May 26, 1995, G.B. Warnke crew found railroad spike with chisled "+"
2/27/1996, corner approved by Remonumentation Peer Group (see dossier for more information).
7/31/1996, G.B. Warnke set 1" x 36" iron pipe with brass remonumentation cap in monument box to replace railroad spike and witnessed as shown below.

RATIFIED BY PEER GROUP
PA 345 OF 1990
MONROE COUNTY, MICHIGAN
date: 2/27/96
County Rep.: [Signature]

C. Description of monument for corner and accessories established to perpetuate locating the position of the corner:

Set 1" x 36" iron pipe with brass remonumentation cap in monument box to replace railroad spike and is accepted as the best available evidence of the position of the original corner and witnessed:
North 89°43" East 98.94 feet to capped 1/2 inch rebar (#19474) at intersection of centerline Rauch Rd. (south line Section 36) & Summerfield Rd.
North 55° West 70.58 feet to found nail/shiner in northeast face of 12 inch maple
North 60° East 78.30 feet to found nail/shiner in south face of telephone pole
South 55° East 74.68 feet to found nail/shiner in north face utility pole

Signed by [Signature] Date Aug 22, 1996
Surveyor's Michigan License No. 19474

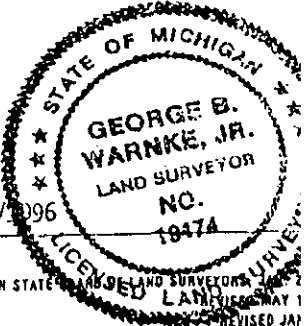

FORM APPROVED BY MICHIGAN STATE BOARD OF LAND SURVEYORS MAY 1 1995 REVISED JAN 1996

G.B. Warnke Corner