

**SURVEY & REMONUMENTATION**

DEC 1 6 1996

**COMMISSION**

**LAND CORNER RECORDATION CERTIFICATE**  
 Filing Requirement of Act 74, Mich. P.A. 1970

RECEIVED FOR RECORD  
 96 SEP -6 PM 1:51

For corners in

MONROE

(County)

Located In:

Corner Code #:

- |                                    |   |           |   |           |             |
|------------------------------------|---|-----------|---|-----------|-------------|
| 1. Public Land Survey              | T | _____     | R | _____     | _____       |
| <b>SUMMERFIELD TWP.</b>            | T | <b>7S</b> | R | <b>6E</b> | <b>M-10</b> |
|                                    | T | _____     | R | _____     | _____       |
|                                    | T | _____     | R | _____     | _____       |
| 2. Property Controlling in Section | S | _____     | T | _____     | _____       |
|                                    | S | _____     | T | _____     | _____       |
| 3. Miscellaneous Property in Sec.  | S | _____     | T | _____     | _____       |
|                                    | S | _____     | T | _____     | _____       |

*Heri Allen*  
 REGISTER OF DEEDS  
 MONROE COUNTY, MICH.

Register of Deeds Stamp & File Number

4. Lot No. \_\_\_\_\_, Recorded Plat \_\_\_\_\_  
 5. Private Claims \_\_\_\_\_

G.B. WARNKE, JR. CORNER

I, G.B. WARNKE, JR., in a field survey on 11/28/1995 & 1996, 19 \_\_\_\_\_, do hereby certify that under requirements of P.A. 74, Michigan P.A. of 1970, the corner points mentioned in lines 1 and 2 above were in conformance with regulations and rules therefore as required in the current manual of survey instructions of the United States Department of the Interior, Bureau of Land Management or by a decree of a Court of Law and/or that the corner points mentioned in lines 3, 4 and 5 above were in conformance with the rules of the Michigan Board of Land Surveyors or by a Decree of a Court of Law; established, re-established, monumented, re-monumented, recovered, found as expressed below:

**NOTE: Not more than 4 corners, all in the same town and range, may be recorded on this certificate.**

	A	B	C	D	E	F	G	H	I	J	K
2	6		5		4		3		2		
3											
4	7		8		9		10		11		
5											
6	18		17		16		15		14		
7											
8	19		20		21		22		23		
9											
10	30		29		28		27		26		
11											
12	31		32		33		34		35		
13											

A. Description of original monument and accessories and/or subsequent restoration:

- East 1/4 Corner to Section 25, on East line of township, at Tunncliffe & Wells Rds. in gravel 1819, GLO Surveyor Joseph Fletcher set 1/4 Section post and witnessed: B. Oak 12" S3°W, 35 lks & B. Oak 9" S18°E, 40 lks;
- M.S.H.D. notes (relocation of U.S. 23) show: 1954-55, found 3/4" I. pipe & 1973, notes 3/4" PIPE (1955) - 1/2" I. PIN 2.15' ENE & 3 witnesses check & 1 gone;
- 1973, G.B. Warnke (survey #73-26, L. 647, Pg. 695) shows SET I. PIN OVER FOUND 3/4" I.P.;
- 1979, L.C.R.C. (L.2, Pg.343) by Glen Richard notes FOUND IRON ROD OVER 3/4" IRON PIPE per 1973 Warnke Survey;
- 1980 & 1981, G.B. Warnke surveys note I. pin over 3/4" I. pipe per M.S.H.D. notes.
- 1986, Case & Fleck survey notes FOUND I.P.; 1988, G.B. Warnke survey notes found 1/2" rebar (found iron SW);
- 1993, J.C. Andrus survey notes FOUND I. PIN (witnesses compare closely to LCRC info.).

B. Description of corner evidence found and/or method applied in restoring or reestablishing corner:

11/28/95 G.B. Warnke field crew found 3/8" x 15" iron rod 2" below gravel roadway, excavated area at 18" deep found 1" (outside diameter) iron pipe with 1" square head bolt inside pipe [found 1/2" I. rod 1.1' N & 1.8" E (2.15' NE direct measurement)] reset 3/8" x 15" iron rod over pipe. 4/9/1996, corner approved by Remonumentation Peer Group (see dossier for further information). 8/1/1996, G.B. Warnke crew set 1" x 36" iron pipe with brass remonumentation cap over existing points and witnesses as shown below.

C. Description of monument for corner and accessories established to perpetuate locating the position of the corner:


Set 1" x 36" iron pipe with brass remonumentation cap over found 3/8" x 15" iron rod over 1" (O.D.) iron pipe with 1" square head bolt in pipe and is accepted as the best available evidence of the position of the original corner and witnesses:  
 Found 1/2" I. rod 1.1" N & 1.8" E (2.15 NE direct measurement), which has been used as corner  
 South 45° East 41.05 feet to found nail in northwest face utility pole  
 South 40° West 38.96 feet to found nail in northeast face of telephone pole  
 North 40° West 55.15 feet to set nail/shiner in southeast face 30 inch Oak  
 South 75° East 77.79 feet north edge of steel sign post

RATIFIED BY PEER GROUP  
 PA 345 OF 1990  
 MONROE COUNTY, MICHIGAN  
 date: 4/9/1996  
 County Rep.: [Signature]

Signed by \_\_\_\_\_

Surveyor's Michigan License No. 19474

G.B. WARNKE, JR. CORNER (Ref 95-0148)

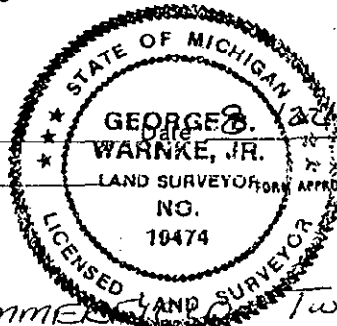

(16) M-10, T7S, R6E, SUMMERFIELD TWP.