

REMONUMENTATION

MAY 2 1987

RECORDED FOR RECORD

LAND CORNER RECORDATION CERTIFICATE 97 JAN 10 PM 1:58  
Filing Requirement of Act 74, Mich. P.A. 1970

For corners in MONROE  
(County)

Located In: Corner Code #

- 1. Public Land Survey  
SUMMERFIELD TWP.  
T 7S R 6E M-12
- 2. Property Controlling in Section  
S      T      R
- 3. Miscellaneous Property in Sec.  
S      T      R

REGISTER OF DEEDS  
MONROE COUNTY, MICH.

Register of Deeds Stamp & File Number

- 4. Lot No. \_\_\_\_\_, Recorded Plat \_\_\_\_\_
- 5. Private Claims \_\_\_\_\_

I, G.B. WARNKE, JR., in a field survey on 1995-1996, 19\_\_\_\_ do hereby state that under requirements of P.A. 74, Michigan P.A. of 1970, the corner points mentioned in lines 1 and 2 above were in conformance with regulations and rules therefore as required in the current manual of survey instructions of the United States Department of the Interior, Bureau of Land Management or by a decree of a Court of Law and/or that the corner points mentioned in lines 3, 4 and 5 above were in conformance with the rules of the Michigan Board of Land Surveyors or by a Decree of a Court of Law; established, re-established, monumented, recovered, found as expressed below:

NOTE: Not more than 2 corners, all in the same town and range, may be recorded on this certificate.

1996 G.B. Warnke, Jr. Corner  
1/4 corner for Section 36  
On Wells Road (gravel)

A	B	C	D	E	F	G	H	I	J	K	L
1											
2	6		5		4		3		2		1
3											
4	7		8		9		10		11		12
5											
6	18		17		16		15		14		13
7											
8	19		20		21		22		23		24
9											
10	30		29		28		27		26		25
11											
12	31		32		33		34		35		36
13											

A. Description of original monument and accessories and/or subsequent restoration:

1819, Joseph Fletcher set G.L.O. post. 1893, B.M. Wilcox set stone. Approximately 1899, L.A. Howard set stone 40.50 (2673.0 feet) chains north of southeast corner, Section 36, T7S, R6E. We measured 2672.79 feet to 5/8 inch I.P. used as M-13. 3/29/1956, stone found per witness card, surveyor unknown. Approximately 1955, Raymond Graf, M.S.H.D. survey chief, found 1/2 inch pipe. 1/15/1960, Angelo J. Marino found old iron 6 inches deep. Case & Fleck surveys recorded in Liber 627, Page 680, notes 1/2" I.P. & Liber 655, Page 909, notes I.P. J.C. Andrus surveys #89S-5620 not existing pipe & #93S-6908 notes iron pin.

B. Description of corner evidence found and/or method applied in restoring or reestablishing corner:


Found 1/2 inch iron pipe in gravel 25 feet west of remains of fence on ground to north - south and in line with south occupation line of Cortz Road. Excavated area and found stone 1.5 feet deep and 1.5 feet south and 1.6 feet east of 1/2 inch pipe. Set 1 inch x 12 inch capped (#19474) iron pipe over high point of stone. 4/9/1996, corner approved by Remonumentation Peer Group. 12/26/96, found 1" x 12" steel pipe with cap (#19474) over high point of sand stone being 18" deep. Found pieces of brick under stone at 36". No post found. Set 5/8" x 24" rod in bottom under set 1" x 36" steel pipe with brass remonumentation cap. Placed pieces of broken stone around base on iron and set 1" x 12" pipe on southerly edge of pipe. Remonumentation cap is 6" +/- below gravel.

C. Description of monument for corner and accessories established to perpetuate locating the position of the corner:

Set 1" x 36" steel pipe with brass remonumentation cap and is accepted as the best available evidence of the position of the original corner and witnessed:  
North 48° West 2.1 feet to found 1/2 inch iron pipe (1.5 foot north and 1.6 foot west)  
North 01° East 14.51 feet to 3/4 inch iron pipe with 1/2 inch iron rod inside  
North 45° East 46.99 feet to found double head nail/shiner in northwest face of utility pole  
South 35° East 75.59 feet to set nail/tag in west face in 10 inch Maple  
West 49.29 feet to set nail/tag in south face of new electric pole  
North 65° West 54.65 feet to set nail/tag in south face of 12" Elm

RATIFIED BY PEER GROUP  
PA 345 OF 1990  
MONROE COUNTY MICHIGAN  
date: 4/9/1996  
County Rep.: [Signature]

Signed by [Signature]  
Surveyor's Michigan License No. 94-0076/95-0036

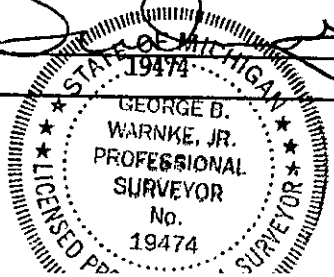

Date 12/27/1996