

**SURVEY & REMONUMENTATION**

DEC 1 8 1996

**LAND CORNER RECORDATION CERTIFICATE**

RECEIVED FOR RECORD

Filing Requirement of Act 74, Mich. P.A. 1970

96 SEP -6 PM 1:56

For corners in MONROE (58) COMMISSION  
(County)

Located In: \_\_\_\_\_ Corner Code ## \_\_\_\_\_

- 1. Public Land Survey T \_\_\_\_\_ R \_\_\_\_\_  
IDA TOWNSHIP T 7S R 7E B-8
- 2. Property Controlling S \_\_\_\_\_ T \_\_\_\_\_ R \_\_\_\_\_  
in Section S \_\_\_\_\_ T \_\_\_\_\_ R \_\_\_\_\_
- 3. Miscellaneous S \_\_\_\_\_ T \_\_\_\_\_ R \_\_\_\_\_  
Property in Sec. S \_\_\_\_\_ T \_\_\_\_\_ R \_\_\_\_\_

*Janis Allen*  
REGISTER OF DEEDS  
MONROE COUNTY, MICH

Register of Deeds Stamp & File Number

- 4. Lot No. \_\_\_\_\_, Recorded Plat \_\_\_\_\_
- 5. Private Claims \_\_\_\_\_

GEORGE B. WARNKE, JR. CORNER

I, G. B. WARNKE, JR., in a field survey on        /        / 1996, 19 \_\_\_\_\_, do hereby certify that under requirements of P.A. 74, Michigan P.A. of 1970, the corner points mentioned in lines 1 and 2 above were in conformance with regulations and rules therefore as required in the current manual of survey instructions of the United States Department of the Interior, Bureau of Land Management or by a decree of a Court of Law and/or that the corner points mentioned in lines 3, 4 and 5 above were in conformance with the rules of the Michigan Board of Land Surveyors or by a Decree of a Court of Law; established, re-established, monumented, re-monumented, recovered, found as expressed below:

	A	B	C	D	E	F	G	H	I	J	K	L
2	6	5	4	3	2							
3												
4	7	8	9	10	11							
5												
6	18	17	16	15	14							
7												
8	19	20	21	22	23							
9												
10	30	29	28	27	26							
11												
12	31	32	33	34	35							
13												

NOTE: Not more than 4 corners, all in the same town and range, may be recorded on this certificate.

A. Description of original monument and accessories and/or subsequent restoration:

Center of Section 19 / On Kruse Road to east & south - gravel surface  
GLD Surveyor did not set center of section.  
1900, Steiner notes "STONE".  
1910, L.A. Howard notes tie to corner (no material noted).  
April 1958, Case & Fleck (ptl. survey) notes "I.P."  
A.J. Marino (field notes): 7/28/62, notes "F.I." & August 1972, notes "PINCHED PIPE" & witnesses:  
"23.48 4" POPLAR & T. POLE 41.11 & 12" ASH 35.82 & 0.8" ASH 42.02 & 21.15 PINCHED PIPE & 24.17 4" POPLAR";  
"CONTINUED ON REVERSE SIDE"

B. Description of corner evidence found and/or method applied in restoring or reestablishing corner:


2/5/96 - G.B. Warnke crew found 2" iron pipe, which fits recorded corner in LCRC, L.1, P.297, as accepted as center of Section 19.  
7/31/1996 - set 1" x 36" iron pipe with brass remonumentation cap to replace 2" iron pipe.

C. Description of monument for corner and accessories established to perpetuate locating the position of the corner:

Set 1" x 36" iron pipe with brass remonumentation cap to replace found 2" Iron Pipe (OD)  
This position not established by original government surveyors. This monument is accepted as the best available evidence of the position of the corner. Witnesses:  
North 65 West 4.25' SE COR OF S STEEL POST OF ARROW SIGN  
NORTH 9.32' SW COR OF W STEEL POST OF ARROW SIGN  
South 55 West 48.34' DH NAIL IN E FACE UTILITY POLE  
North 45 East 40.54' DH NAIL IN SE FACE UTILITY POLE  
South 45° East 47.74' DH NAIL IN SW FACE 10" DIA. x 4.5' HI WOOD POLE

RATIFIED BY PEER GROUP  
PA 345 OF 1990  
MONROE COUNTY, MICHIGAN  
date: 6/11/96  
County Rep.: [Signature]

Signed by [Signature]  
Surveyor's Michigan License No. 19474

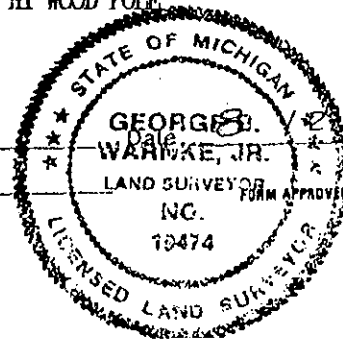

G.B. WARNKE CORNER

FORM APPROVED BY MICHIGAN STATE BOARD OF LAND SURVEYORS, JAN. 28, 197  
REVISED MAY 14, 197  
REVISED JAN. 198

## "Continued from Section A"

March 1973, Glenn Richard (LCRC - L.1, P.297) notes "FOUND 2" IRON PIPE" and witnesses:

"FOUND NAIL & WASHER IN 16" BASSWOOD N85°W 45.33 &  
 FOUND NAIL & WASHER IN 4' BASSWOOD S65°W 26.40 &  
 DOUBLE HEADED NAIL IN ELECTRIC POLE S40°W 48.34;

August 1975, Case & Fleck (surveys) notes "FD. 2" I.P." & witnesses: "N35°E 40.55 NAIL P.POLE &  
 S35°W 48.50 NAIL P.POLE";

10/5/76, G.B. Warnke (Survey #76-161) notes "FD 1 1/2" I. PIPE" & witnesses:

"N30°E 40.55 NAIL IN SE FACE OF ELEC. POLE &  
 S30°W 48.30 NAIL IN EAST FACE OF ELEC. POLE &  
 WEST 45.28 NAIL IN BLAZE IN S. FACE OF COTTONWOOD";

11/20/87, G.B. Warnke (Survey #87-512) notes "FOUND PINCHED PIPE" & witnesses:

"N35°E 41.49' TO NAIL IN S. SIDE POWER POLE  
 S38°W 47.47' TO NAIL IN E. SIDE POWER POLE  
 S45°E 45.89' TO DH NAIL IN W. SIDE POWER POLE  
 WEST 45.96' TO DH NAIL S. SIDE 24" POPLAR  
 N23°W 1.77' TO 2" IRON PIPE";

2/5/96, G.B. Warnke (Survey #96-0009) notes "LCRC, L.1, P.297 - FOUND 2" I PIPE (OD)" & witnesses:

"N65W 4.25' SE COR OF S STEEL POST OF ARROW SIGN  
 NORTH 9.32' SW COR OF W STEEL POST OF ARROW SIGN  
 S55W 48.34' DH NAIL IN E FACE UTILITY POLE  
 N45E 40.54' DH NAIL IN SE FACE UTILITY POLE"  
 S45°E 47.74' DH NAIL IN SW FACE 10" DIA. x 4.5' HI WOOD POLE;

SURVEY &  
 REMONUMENTATION

DEC 1 8 1996

COMMISSION