

**SURVEY &
REMONUMENTATION**

APR 28 1995

RATIFIED BY PEER GROUP
PA 345 OF 1990
MONROE COUNTY, MICHIGAN
date: 11/29/1994
County Rep.: [Signature]

**COMMISSION
LAND CORNER RECORDATION CERTIFICATE
Filing Requirement of Act 74, Mich. P.A. 1970**

RECEIVED FOR RECORD
94 DEC 16 PM 3:22

[Signature]
REGISTER OF DEEDS
MONROE COUNTY, MICH

Register of Deeds Stamp & File Number

For corners in MONROE (County) Located In: IDA TWP. Corner Code ##

- | | | |
|------------------------------------|---------------------------|-------|
| 1. Public Land Survey | T <u>7</u> S R <u>7</u> E | C-2 |
| | T _____ R _____ | _____ |
| | T _____ R _____ | _____ |
| | T _____ R _____ | _____ |
| 2. Property Controlling in Section | S _____ T _____ R _____ | _____ |
| | S _____ T _____ R _____ | _____ |
| 3. Miscellaneous Property in Sec. | S _____ T _____ R _____ | _____ |
| | S _____ T _____ R _____ | _____ |

4. Lot No. _____, Recorded Plat _____
5. Private Claims _____

1994 MONROE COUNTY REMONUMENTATION PROGRAM
Peer Group approved corner on 11/29/1994 per Act 345 of 1990.

I, G.B. WARNKE, JR., in a field survey on 11/30/1994, 19____ do hereby certify that under requirements of P.A. 74, Michigan P.A. of 1970, the corner points mentioned in lines 1 and 2 above were in conformance with regulations and rules therefore as required in the current manual of survey instructions of the United States Department of the Interior, Bureau of Land Management or by a decree of a Court of Law and/or that the corner points mentioned in lines 3, 4 and 5 above were in conformance with the rules of the Michigan Board of Land Surveyors or by a Decree of a Court of Law; established, re-established, monumented, re-monumented, recovered, found as expressed below:

NOTE: Not more than 4 corners, all in the same town and range, may be recorded on this certificate.

A. Description of original monument and accessories and/or subsequent restoration:


C-2, T7S, R7E, Ida Township, Monroe County - ID No. 58
1/4 Corner Common to Sections 5 & 6 (off roads, 1/2 mile north of intersection of Albain & Secor Roads) 1820, G.L.O. Surveyor, Joseph Wampler, set qr. Sec. post: B. Oak 9 (inch) S.54°W. 44 (links) & B. Oak 10 (inch) N.37°W. 65 (links). 1900, VanDeventer notes stone. 1972, M. Freels survey, recorded in Liber 630, Page 944, notes old stone fd. 1976, Glenn Richard recorded LCRC, Liber 2, Page 142, found stone and set 3/4" x 4' iron pipe on north side of stone. 1977, G.B. Warnke survey, recorded in Liber 750, Page 773, notes found iron pipe N. side of stone. 1990, G.B. Warnke notes found stone with iron on north side, recorded in LCRC's, Liber 3, Page 89 & Liber 3, Page 108, and in survey in Liber 1119, Page 0182.

B. Description of corner evidence found and/or method applied in restoring or reestablishing corner:

C-2 - 11/1994, found stone and witnessed as shown below. 11/30/1994, set 1 inch x 36 inch iron pipe with brass remonumentation cap to replace found stone.

C. Description of monument for corner and accessories established to perpetuate locating the position of the corner:

C-2 - Set 1 inch x 36 inch iron pipe with brass remonumentation cap to replace found stone (used high point) and is accepted as the best available evidence of the position of the original corner and Witnesses:
North 0.22 feet to capped iron pipe No. 13040
North 32.08 feet to found double head nail on west side of 8 inch Cherry tree
South 45° West 3.28 feet to set nail/shiner east side of 50 inch Oak stub
East 48.43 feet to set nail/shiner on east side of 18 inch Oak tree
North 80° West 14.21 feet to set nail/shiner in south side of 8 inch Oak tree

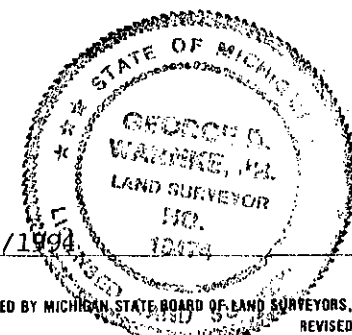

Signed by [Signature] Date 11/30/1994
Surveyor's Michigan License No. 19474