

**SURVEY &
REMONUMENTATION**

APR 28 1995

COMMISSION

LAND CORNER RECORDATION CERTIFICATE
Filing Requirement of Act 74, Mich. P.A. 1970

RATIFIED BY PEER GROUP
PA 345 OF 1990
MONROE COUNTY, MICHIGAN

date: 11/8/1994
County Rep.: [Signature]

For corners in
MONROE
(County)

Located In: IDA TWP. Corner Code ##

RECEIVED FOR RECORD
94 DEC 16 PM 3:23

[Signature]
REGISTER OF DEEDS
MONROE COUNTY, MICH

Register of Deeds Stamp & File Number


1. Public Land Survey	T <u>7</u> S R <u>7</u> E	C-3
	T ___ R ___	_____
	T ___ R ___	_____
	T ___ R ___	_____
2. Property Controlling in Section	S ___ T ___ R ___	_____
	S ___ T ___ R ___	_____
3. Miscellaneous Property in Sec.	S ___ T ___ R ___	_____
	S ___ T ___ R ___	_____

4. Lot No. _____, Recorded Plat _____
5. Private Claims _____

1994 MONROE COUNTY REMONUMENTATION PROGRAM

Peer Group approved corner on 11/8/1994 per Act 345 of 1990.

I, G.B. WARNKE, JR., in a field survey on 11/22/1994, 19____, do hereby certify that under requirements of P.A. 74, Michigan P.A. of 1970, the corner points mentioned in lines 1 and 2 above were in conformance with regulations and rules therefore as required in the current manual of survey instructions of the United States Department of the Interior, Bureau of Land Management or by a decree of a Court of Law and/or that the corner points mentioned in lines 3, 4 and 5 above were in conformance with the rules of the Michigan Board of Land Surveyors or by a Decree of a Court of Law; established, re-established, monumented, re-monumented, recovered, found as expressed below:

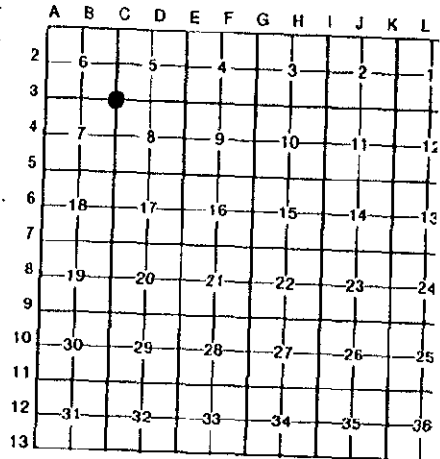

NOTE: Not more than 4 corners, all in the same town and range, may be recorded on this certificate.

A. Description of original monument and accessories and/or subsequent restoration:

C-3, T7S, R7E, Ida Township, Monroe County - ID No. 58 Corner Common to Sections 5, 6, 7 and 8 (Albain and Secor Roads - 10 inch asphalt over 24 inch stone over 12 inch top soil over yellow sand) 1820, G.L.O. Surveyor, Joseph Wampler, set post corner of Sections 5, 6, 7 & 8 and witnessed: W. Oak 16 (inch) S.39°E. 81 (links) & B. Oak 20 (inch) S.46°W. 128 (links). 1939 & 1956, Angelo J. Marino used stone. 1972, Case & Fleck noted F. iron. 1974, M.R. Fleck noted F.I.R. over stone. 1972 to date, Case & Fleck, M. Freels, G.B. Warnke, Glenn Richard, Gordon MacCannon, & A.J. Marino used rod.

B. Description of corner evidence found and/or method applied in restoring or reestablishing corner:

C-3 - 9/4/1994, found 5/8 inch iron rod being 2 feet long. Dug a 18 inch X 48 inch hole, found a line stone at 30 inches deep under rod, removed stone, no post found. Set a 1 inch X 36 inch iron pipe in place of stone and rod and witnessed as shown below. 11/22/1994, set brass remonumentation cap on 1 inch x 36 inch iron pipe inside set monument box.

C. Description of monument for corner and accessories established to perpetuate locating the position of the corner:

C-3 - Set 1 inch X 36 inch iron pipe with brass remonumentation cap with monument box to replace 5/8 inch rod and stone is accepted as the best available evidence of the position of the original corner and

Witnesses:
North 46.82 feet found nail/shiner in east face electric pole
North 25° West 126.12 feet southeast corner of attached garage
North 50° West 37.73 feet found nail in southwest side of 18 inch Maple
South 45° West 113.10 in northeast corner of house No. 3814

Signed by [Signature] Date 11/22/1994

Surveyor's Michigan License No. 19474

