

RATIFIED BY PEER GROUP
PA SEC OF 1990
MONROE COUNTY, MICHIGAN

date: 9/20/94
County Rep.: [Signature]

LAND CORNER RECORDATION CERTIFICATE
Filing Requirement of Act 74, Mich. P.A. 1970

RECEIVED FOR RECORD

95 SEP 15 AM 11:20

For corners in
Monroe (58)
(County)

Located In: Corner Code #

- | | | | |
|---------------------------------------|---|---|-----|
| 1. Public Land Survey
IDA Twp | T | R | |
| | T | R | C-4 |
| | T | R | |
| | T | R | |
| 2. Property Controlling
in Section | S | T | R |
| | S | T | R |
| 3. Miscellaneous
Property in Sec. | S | T | R |
| | S | T | R |

[Signature]
REGISTER OF DEEDS
MONROE COUNTY, MICH

**SURVEY &
REMONUMENTATION**

Register of Deeds Stamp & File Number

APR 04 1996

4. Lot No. _____, Recorded Plat _____
5. Private Claims _____

COMMISSION

A	B	C	D	E	F	G	H	I	J	K	L
2	6	5	4	3	2	1					
3											
4	7	8	9	10	11	12					
5											
6	16	17	18	19	20	21	22	23	24		
7											
8	10	20	21	22	23	24					
9											
10	30	29	28	27	26	25					
11											
12	31	32	33	34	35	36					
13											

CORNER SUBMITTED BY GEORGE B. WARNKE, JR., P.S.

I, G.B. WARNKE, JR., in a field survey on 1994 & 1995, 19 _____, do hereby certify that under requirements of P.A. 74, Michigan P.A. of 1970, the corner points mentioned in lines 1 and 2 above were in conformance with regulations and rules therefore as required in the current manual of survey instructions of the United States Department of the Interior, Bureau of Land Management or by a decree of a Court of Law and/or that the corner points mentioned in lines 3, 4 and 5 above were in conformance with the rules of the Michigan Board of Land Surveyors or by a Decree of a Court of Law; established, re-established, monumented, re-monumented, recovered, found as expressed below:

NOTE: Not more than 4 corners, all in the same town and range, may be recorded on this certificate.

A. Description of original monument and accessories and/or subsequent restoration:


1/4 Corner Common to Sec. 7 & 8 (Secor Road - 1/2 mile south of Albain Road - 10" gravel, yellow sand, 1820, G.L.O. Surveyor, Joseph Wampler, set quarter section post between Sections 7 & 8, witnessed: B. Oak 14 inch S.10° W. 33 links & B. Oak 16 inch N.41° E. 58 links. Mid to late 1800's, found stake on east side of section (7) properly set in right line at average distance for 1/4 post. 1939, Monroe County Road Commission found stone on fence line to east. 1972, M.R. Fleck used F. iron per surveys recorded in Liber 626, Page 166, & Liber 626, Page 663-664. 1972, Merideth Freels used iron pin found per survey recorded in Liber 629, Page 616. 1973, Glenn Richard found 5/8 inch iron rod on south side 12 inch diameter stone recorded in L.C.R.C., Liber 1, Page 241. As recent as 1981, Glenn Richard has used this corner location.

B. Description of corner evidence found and/or method applied in restoring or reestablishing corner:

9/1994, found 5/8 inch x 18 inch iron rod being 1 inch below surface. Dug 18" x 24" hole and found granite stone. High point of stone was 0.22 feet north and 0.14 feet west of rod. Replaced stone with set 1 inch x 36 inch iron pipe. 1995, Monroe County Road Commission set monument box after repaving the road. 8/23/1995, G.B. Warnke set brass cap on iron pipe and witnessed as shown below.

C. Description of monument for corner and accessories established to perpetuate locating the position of the corner:

Set 1 inch x 36 inch iron pipe with brass remonumentation cap inside monument box to replace stone and is accepted as the best available evidence of the position of the corner and Witnesses:
North 30° West 106.68 feet to found PK nail in east face of electric pole
East 33.33 feet to west face of 4 inch square concrete post
South 85° East 32.21 feet to found PK nail in south face of 10 inch Oak tree
West 32.87 feet to found 5/8 inch iron rod
South 40° East 64.60 feet to found nail/shiner in southwest face of 10 inch Oak tree

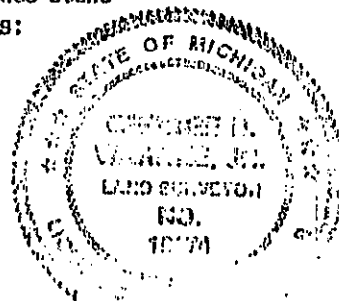

Signed by [Signature]
Surveyor's Michigan License No. 19474

Date 8/24/1995

21 C-4 (7/7) IDA TWP. 4 PAGE 12