

RATIFIED BY PEER GROUP  
PA 445 OF 1990  
MONROE COUNTY, MICHIGAN

date: 9/29/95

County Rep.: [Signature]  
For corners in  
Monroe (58)

LAND CORNER RECORDATION CERTIFICATE  
Filing Requirement of Act 74, Mich. P.A. 1970

RECEIVED FOR RECORD

95 SEP 15 AM 11:22

*Mari Allen*  
REGISTER OF DEEDS  
MONROE COUNTY, MICH

Located In: \_\_\_\_\_ Corner Code: #  
1. Public Land Survey T \_\_\_\_\_ R \_\_\_\_\_  
IDA TWP. T 7S R 7E C-5  
T \_\_\_\_\_ R \_\_\_\_\_  
T \_\_\_\_\_ R \_\_\_\_\_  
2. Property Controlling S \_\_\_\_\_ T \_\_\_\_\_ R \_\_\_\_\_  
in Section S \_\_\_\_\_ T \_\_\_\_\_ R \_\_\_\_\_  
3. Miscellaneous S \_\_\_\_\_ T \_\_\_\_\_ R \_\_\_\_\_  
Property in Sec. S \_\_\_\_\_ T \_\_\_\_\_ R \_\_\_\_\_

SURVEY &  
REMONUMENTATION

Register of Deeds Stamp & File Number

APR 04 1996

4. Lot No. \_\_\_\_\_, Recorded Plat \_\_\_\_\_  
5. Private Claims \_\_\_\_\_

COMMISSION

CORNER SUBMITTED BY GEORGE B. WARNKE, JR., P.S.

	A	B	C	D	E	F	G	H	I	J	K	L	M
2													
3													
I, G. B. WARNKE, JR., in a field survey on 1994 & 1995, 19 \_\_\_\_\_, do hereby certify that under requirements of P.A. 74, Michigan P.A. of 1970, the corner points mentioned in lines 1 and 2 above were in conformance with regulations and rules therefore as required in the current manual of survey instructions of the United States Department of the Interior, Bureau of Land Management or by a decree of a Court of Law and/or that the corner points mentioned in lines 3, 4 and 5 above were in conformance with the rules of the Michigan Board of Land Surveyors or by a Decree of a Court of Law; established, re-established, monumented, re-monumented, recovered, found as expressed below:

NOTE: Not more than 4 corners, all in the same town and range, may be recorded on this certificate.

A. Description of original monument and accessories and/or subsequent restoration:

Section Corner Common to Sections 7, 8, 17 & 18  
(Lulu & Secor Roads - stone chip & tar 1 inch, asphalt 3 inches, stone 8 inches, yellow sand)  
1820, G.L.O. Surveyor, Joseph Wampler, set post at corner of Sections 7, 8, 17 & 18 and witnesses: B. Oak 27 inch S.4° E. 50 links & B. Oak 20 inch N.30° W. 55 links. 1887, Willis Baldwin found old stake at SE corner of Section 7. 1903, L.A. Howard found stone at NW corner of Section 17. 1956, A.J. Marino notes P. cap. 1973, Glenn Richard found R.R. spike in pavement per L.C.R.C., Liber 1, Page 241 and 4 recorded surveys using this corner. 1978, M.R. Fleck notes F. iron rod and has one common witness with Richard's corner. 1979, G.B. Warnke notes iron rod in place of R.R. spike and in 1989 he re-witnesses the corner and recorded in L.C.R.C., Liber 3, Page 70.

B. Description of corner evidence found and/or method applied in restoring or reestablishing corner:


9/1/1994, found 5/8 inch iron rod being 12 inches long and 1 inch below surface. Dug 20 inch x 24 inch hole, probed in all directions, and no other evidence of stone or post found. Set 1 inch x 36 inch iron pipe in place of iron rod. 1995, Monroe County Road Commission set monument box. 8/95, G.B. Warnke set brass remonument cap on iron pipe. Witnessed as shown below.

C. Description of monument for corner and accessories established to perpetuate locating the position of the corner:

Set 1 inch x 36 inch iron pipe with brass remonumentation cap inside monument box to replace rod and is accepted as the best available evidence of the position of the original corner and Witnesses:  
North 50° West 60.88 feet to nail/shiner in southwest face of 40 inch Oak stump  
North 10° East 133.00 feet to nail/shiner in west face of 36 inch tree  
North 50° East 37.96 feet to nail in south face of electric pole  
South 60° East 54.76 feet to nail in north face of telephone pole

Signed by [Signature]  
Surveyor's Michigan License No. 19474

Date August, 1995

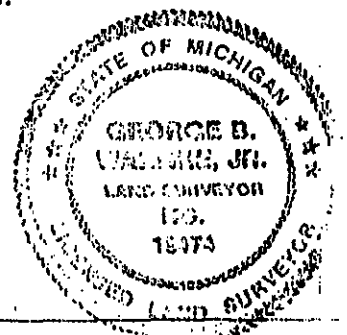

(17) C-5 (7/7)