

RATIFIED BY PEER GROUP
PA 645 OF 1970
MONROE COUNTY, MICHIGAN
date: 9/20/94
County Rep. [Signature]

LAND CORNER RECORDATION CERTIFICATE
Filing Requirement of Act 74, Mich. P.A. 1970

RECEIVED FOR RECORD
95 SEP 15 AM 11:21

Mark Allen
REGISTER OF DEEDS
MONROE COUNTY, MICH

For corners in
Monroe (58)
(County)

Located in: _____ Corner Code # _____

1. Public Land Survey
IDA TWP. T 7S R 7E C-6

2. Property Controlling
in Section S _____ T _____ R _____

3. Miscellaneous
Property in Sec. S _____ T _____ R _____

SURVEY & REMONUMENTATION

Register of Deeds Stamp & File Number

4. Lot No. _____, Recorded Plat _____
5. Private Claims _____
CORNER SUBMITTED BY GEORGE B. WARNKE, JR. P.S.

APR 04 1996
COMMISSION

I, G.B. WARNKE, JR., in a field survey on 1994 & 1995, 19 _____, do hereby certify that under requirements of P.A. 74, Michigan P.A. of 1970, the corner points mentioned in lines 1 and 2 above were in conformance with regulations and rules therefore as required in the current manual of survey instructions of the United States Department of the Interior, Bureau of Land Management or by a decree of a Court of Law and/or that the corner points mentioned in lines 3, 4 and 5 above were in conformance with the rules of the Michigan Board of Land Surveyors or by a Decree of a Court of Law; established, re-established, monumented, re-monumented, recovered, found as expressed below:

	A	B	C	D	E	F	G	H	I	J	K	L	M
2													
3													
NOTE: Not more than 4 corners, all in the same town and range, may be recorded on this certificate.

A. Description of original monument and accessories and/or subsequent restoration:


1/4 Section Corner Common to Sections 17 & 18 (Secor Road, 1/2 mile south of Lulu Road - gravel) 1820, G.L.O. Surveyor, Joseph Wampler, set quarter section post between sections 17 & 18 and witnesses: Aspen 9 inch N.31° E. 28 links & B. Oak 14 inch S.1/4° E. 33 links. 1887, Willis Baldwin found stone. 1903, L.A. Howard found stone. 1953, A.J. Marino found stone used again in 1957 and 1965. In 1973, Glenn Richard performed surveys recorded in Liber 646, Page 99 and Liber 646, Page 101, and recorded L.C.R.C., Liber 1, Page 305, to found stone with cross cut and set iron pipe on west side of stone being 0.32 feet west of cross. 1989, G.B. Warnke notes found 1/2 inch iron pipe 0.9 feet deep raised with railroad spike and recorded in L.C.R.C., Liber 3, Page 70.

B. Description of corner evidence found and/or method applied in restoring or reestablishing corner:

9/1/1994, found a 1/2 inch iron pipe being 6 inches deep; iron pipe looks disturbed and was leaning to the south. Dug 18 inch x 24 inch hole and hit a plastic 6 inch drain tile with white sock. Talked to an old man who lived at residence No. 5340 Secor Road, he said that he saw a flat stone about 6 inches deep that a surveyor had used and he recalls that a tile company came through about a year ago & placed tile down the centerline of the road from the drain to the south. Also talked to man by the name of Mike at residence no. 5331 Secor Road and he said the same; he recalled the company that did the tile work as Laser Shot. We pulled the witnesses from L.C.R.C, Liber 3, Page 70, and dug 20 inch x 40 inch in area but no stone or post found. Found 6 inch drain tile 24 inches deep under witness crossing. Set 1 inch x 36 inch iron pipe at witness crossing. Witness crossing is 4.94 feet north of found 1/4 inch iron pipe.
Measured distance to the north to C-5 at 2661.20 feet (2661.09 feet per Warnke in 1989)
Measured distance to the south to C-7 at 2598.52 feet (2598.59 feet per A.J. Marino in 1953)
1995, Road Commission set monument box & Warnke set brass cap on iron. Witnesses as shown below.

C. Description of monument for corner and accessories established to perpetuate locating the position of the corner:

Set 1 inch x 36 inch iron pipe with brass remonumentation cap inside monument box, at previous location of 1/2 inch iron pipe raised with railroad spike and is accepted as the best available evidence of the position of the original corner and Witnesses:
North 85° East 126.65 feet to southwest corner of brick house no. 5331
South 50° East 30.57 feet to nail/shiner in southwest face of telephone pole
South 55° West 105.97 feet to northeast corner of residence no. 5340
West 24.63 feet railroad spike in east face of telephone pole

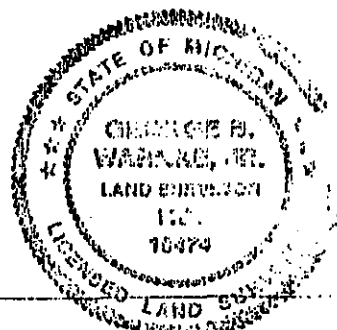

Signed by [Signature] Date / / 1995
Surveyor's Michigan License No. 19474

(14) C-6 (7/7)