

RATIFIED BY PEER GROUP  
PA 345 OF 1990  
MONROE COUNTY, MICHIGAN

LAND CORNER RECORDATION CERTIFICATE  
Filing Requirement of Act 74, Mich. P.A. 1970

date: 11/28/1995  
For corners in [Signature]  
Monroe (58)  
(County)

Located In: \_\_\_\_\_ Corner Code # \_\_\_\_\_  
1. Public Land Survey T \_\_\_\_\_ R \_\_\_\_\_  
IDA TWP. T 7S R 7E C-10  
T \_\_\_\_\_ R \_\_\_\_\_  
T \_\_\_\_\_ R \_\_\_\_\_  
2. Property Controlling S \_\_\_\_\_ T \_\_\_\_\_ R \_\_\_\_\_  
in Section S \_\_\_\_\_ T \_\_\_\_\_ R \_\_\_\_\_  
3. Miscellaneous S \_\_\_\_\_ T \_\_\_\_\_ R \_\_\_\_\_  
Property in Sec. S \_\_\_\_\_ T \_\_\_\_\_ R \_\_\_\_\_

RECEIVED FOR RECORD  
95 DEC 29 AM 9:05  
REGISTER OF DEEDS  
MONROE COUNTY, MICH

Register of Deeds Stamp & File Number

4. Lot No. \_\_\_\_\_, Recorded Plat APR 04 1996  
5. Private Claims \_\_\_\_\_

COMMISSION

1995 REMONUMENTATION PROGRAM

I, G.B. WARNKE, JR., in a field survey on Oct-Dec, 1995, 19 \_\_\_\_\_, do hereby certify that under requirements of P.A. 74, Michigan P.A. of 1970, the corner points mentioned in lines 1 and 2 above were in conformance with regulations and rules therefore as required in the current manual of survey instructions of the United States Department of the Interior, Bureau of Land Management or by a decree of a Court of Law and/or that the corner points mentioned in lines 3, 4 and 5 above were in conformance with the rules of the Michigan Board of Land Surveyors or by a Decree of a Court of Law; established, re-established, monumented, re-monumented, recovered, found as expressed below:

|    | A  | B  | C  | D  | E  | F  | G | H | I | J | K | L |
|----|----|----|----|----|----|----|---|---|---|---|---|---|
| 2  | 6  | 5  | 4  | 3  | 2  | 1  |   |   |   |   |   |   |
| 3  |    |    |    |    |    |    |   |   |   |   |   |   |
| 4  | 7  | 8  | 9  | 10 | 11 | 12 |   |   |   |   |   |   |
| 5  |    |    |    |    |    |    |   |   |   |   |   |   |
| 6  | 16 | 17 | 18 | 15 | 14 | 13 |   |   |   |   |   |   |
| 7  |    |    |    |    |    |    |   |   |   |   |   |   |
| 8  | 19 | 20 | 21 | 22 | 23 | 24 |   |   |   |   |   |   |
| 9  |    |    |    |    |    |    |   |   |   |   |   |   |
| 10 | 30 | 29 | 28 | 27 | 26 | 25 |   |   |   |   |   |   |
| 11 |    |    |    |    |    |    |   |   |   |   |   |   |
| 12 | 31 | 32 | 33 | 34 | 35 | 36 |   |   |   |   |   |   |
| 13 |    |    |    |    |    |    |   |   |   |   |   |   |

NOTE: Not more than 4 corners, all in the same town and range, may be recorded on this certificate.

A. Description of original monument and accessories and/or subsequent restoration:

1/4 Corner common to Sections 29 & 30 / On Secor Road - hard surface  
1820, GLO Surveyor, J. Wampler, set qr. Sec. post - witnesses: B. Oak 14 N.55W. 99 & B. Oak 6 N.11E. 84.  
W. Baldwin in early 1900's & A.F. Winney in 1894 have notes in Sections 29 & 30 give breakdowns of atleast a portion of the sections. 1959, M.R. Fleck, Survey #5998, used corner but material not noted.  
1970's survey, surveyor not shown, notes FOUND IRON PIN, 1.2' BELOW SURFACE, SET R.R. SPIKE AT SURFACE.  
1971, M. Freels, Survey #71-007, W1/4 CORNER, SEC. 29 AS PER THE REFERENCES FROM THE MONROE CO. ROAD COMMISSION. 1972, M.R. Fleck, Survey #16994, used corner but material not noted. 1973, M.R. Fleck, Survey #17226 & 17109, notes FND. IRON. 1978, G.B. Warnke notes R.R. SPIKE. 1993, J.C. Andrus, LCRC, Liber 3, Page 255, notes FOUND R.R. SPIKE. 1994, G.B. Warnke found R.R. SPIKE.


B. Description of corner evidence found and/or method applied in restoring or reestablishing corner:

10/23/1995 - G.B. Warnke crew found railroad spike being 4 inches below surface. Found 3/4" x 27" iron rod being 1.3 feet below surface. Top of rod was bent to the north-northeast and straight part of rod was 0.05 feet south of the railroad spike. Dug a 20" x 46" hole and hit a vitrified drainage tile and/or cross tile (east & west across road) being 1.6 feet north of railroad spike. No other evidence was found. It is assumed that any previous evidence was destroyed when the tile was placed. Set 1" x 36" iron pipe inside monument box to replace points. 11/28/1995 - corner was Peer Group approved.  
12/5/95 - set brass remonumentation cap on previously set 1" x 36" iron pipe.

C. Description of monument for corner and accessories established to perpetuate locating the position of the corner:

Set 1" x 36" iron pipe with brass remonumentation cap inside monument box and is accepted as the best available evidence of the position of the original corner and witnesses:  
North 80° West 59.60 feet to set nail/shiner in south face of 30" Oak tree  
North 85° East 37.37 feet to set nail/shiner in south face of 48" (twin 24") Oak tree  
North 35° East 64.97 feet to set nail/shiner in south face of 14" Oak tree  
North 70° West 43.27 feet to found nail/shiner in southeast face of electric pole

Signed by [Signature] Date 12/19/1995  
Surveyor's Michigan License No. 19474

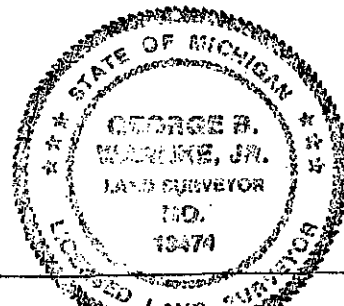

FORM APPROVED BY MICHIGAN STATE BOARD OF LAND SURVEYORS, JAN. 28, 15  
REVISED MAY 14, 15  
REVISED JAN., 15

(16) C-10 (717) Ida

UNM 4 Pasi 82